Iona Drainage District


IONA DRAINAGE DISTRICT.

Lee County, Florida.

A. L. White,
Chief Engineer

Hor. Scale 1" = 400'
Vert. Scale 1" = 4'

PROFILE
LINE A (Sta. 0 to 110)

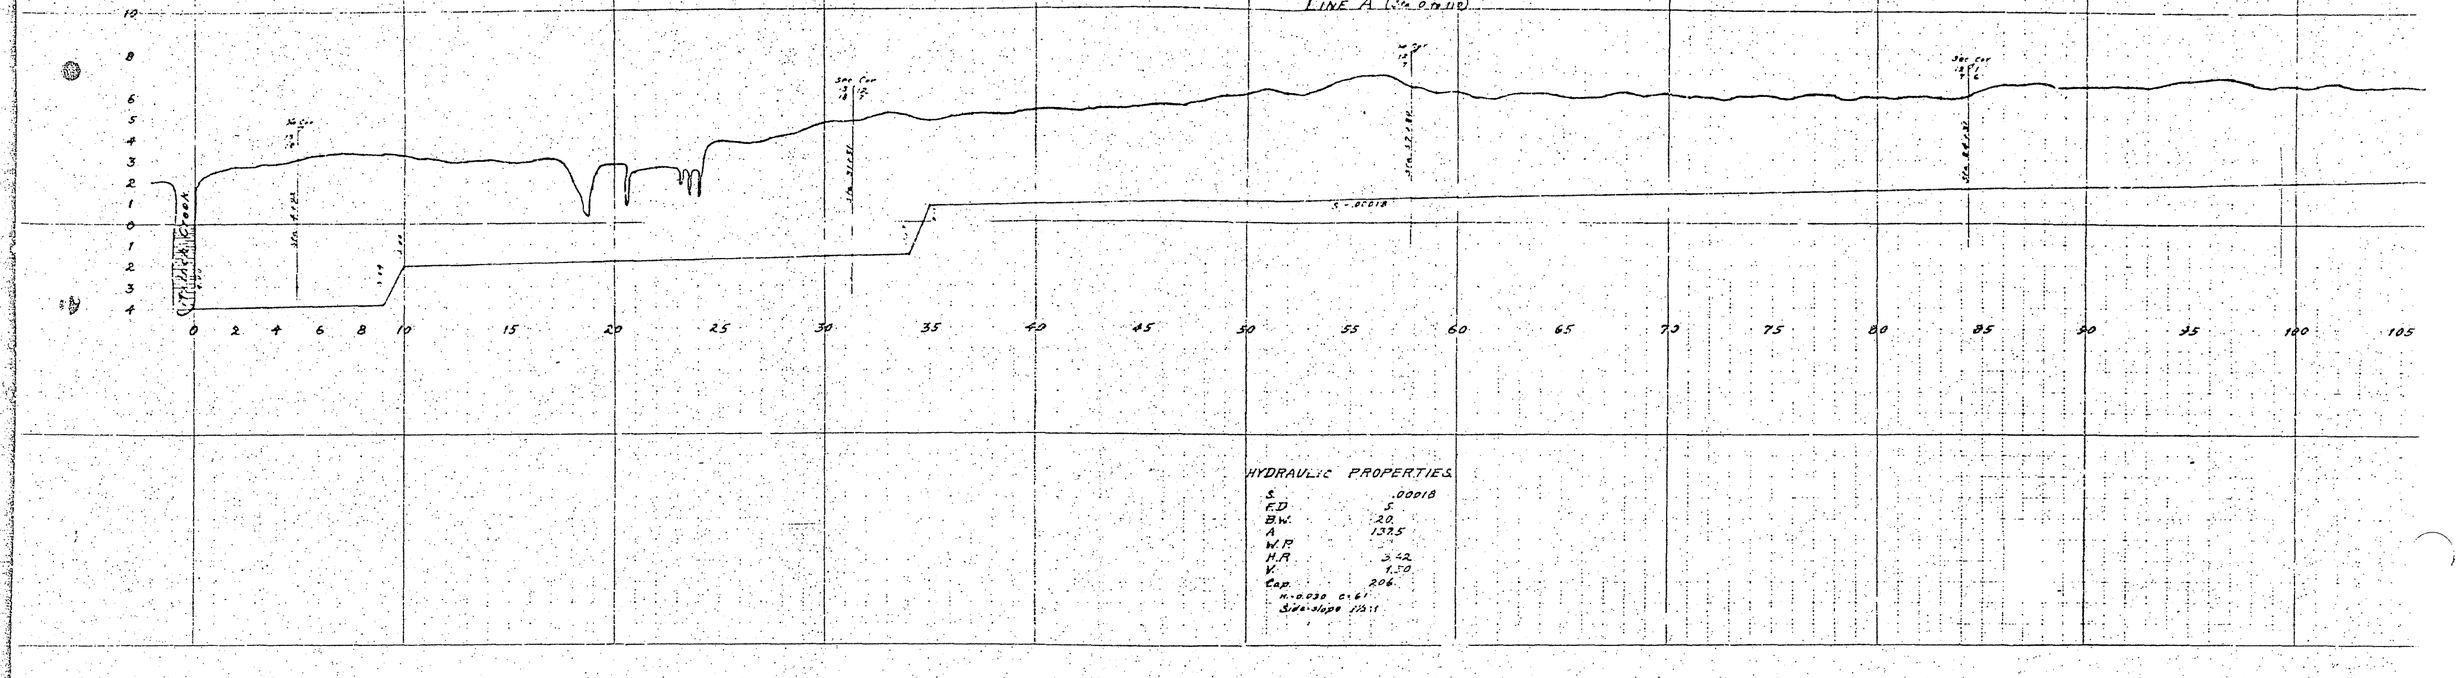


HYDRAULIC PROPERTIES

S	.00018
F.D	5
B.W.	20
A	1375
W.P.	
H.R	3.42
V	1.50
Cap.	206

n = 0.030 c = 6'
Side slope 1:1

PLAN
LINE A, Sta. 0 to 110.

S ⟶ N

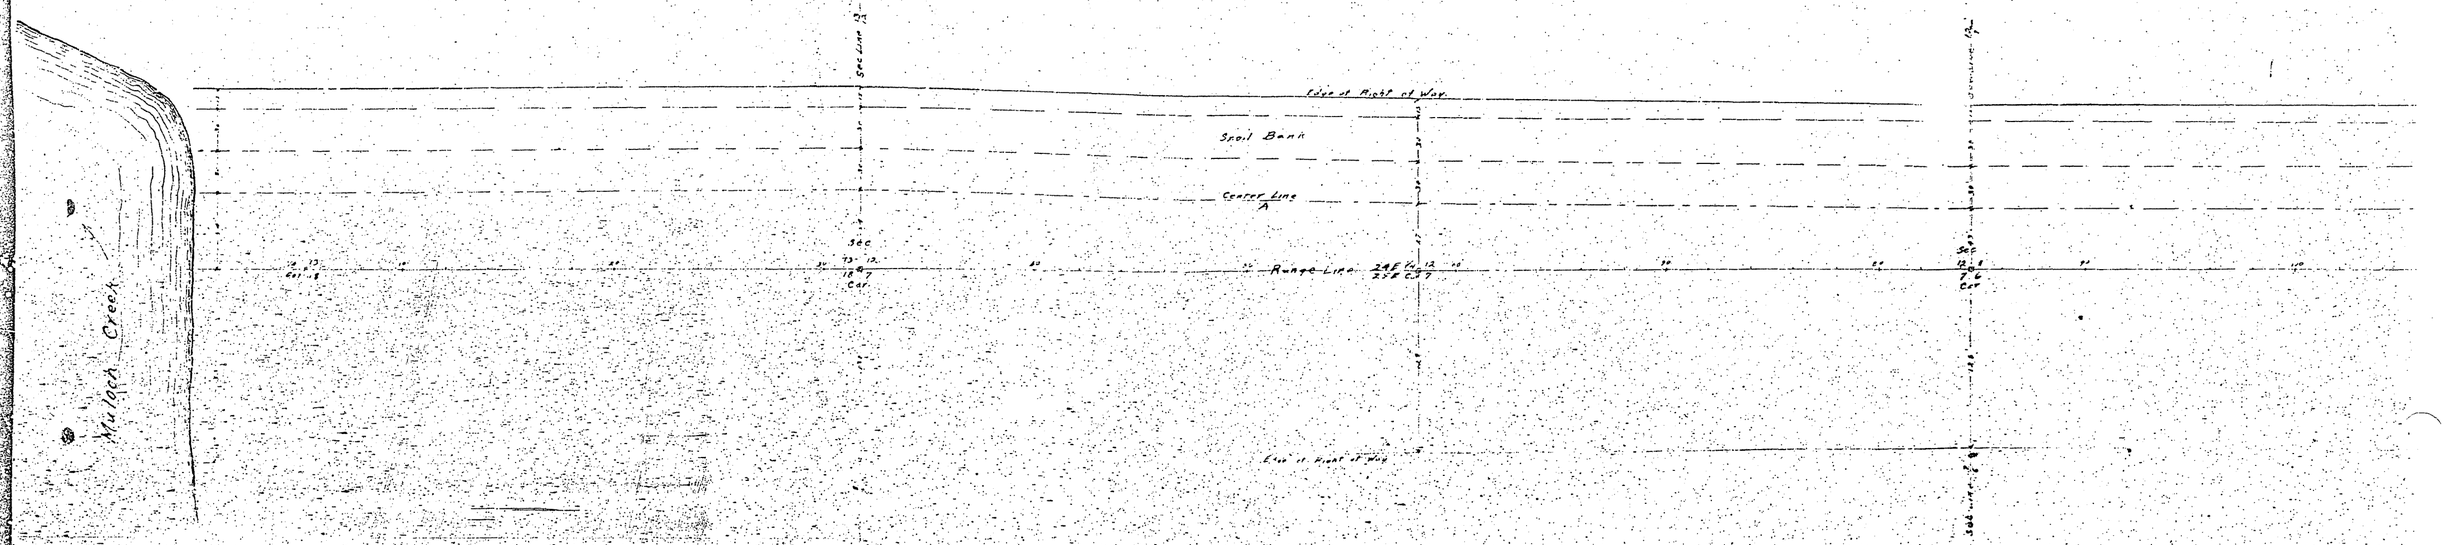

STANDARD PROFILE PLATE A 4270


IONA DRAINAGE DISTRICT
Lee County, Florida.

A.L. White
Chief Engineer

Hor. Scale 1"=400'
Vert. Scale 1"=4'

Folio
Sheet

PROFILE
LINE A (Sta. 100 to 210)

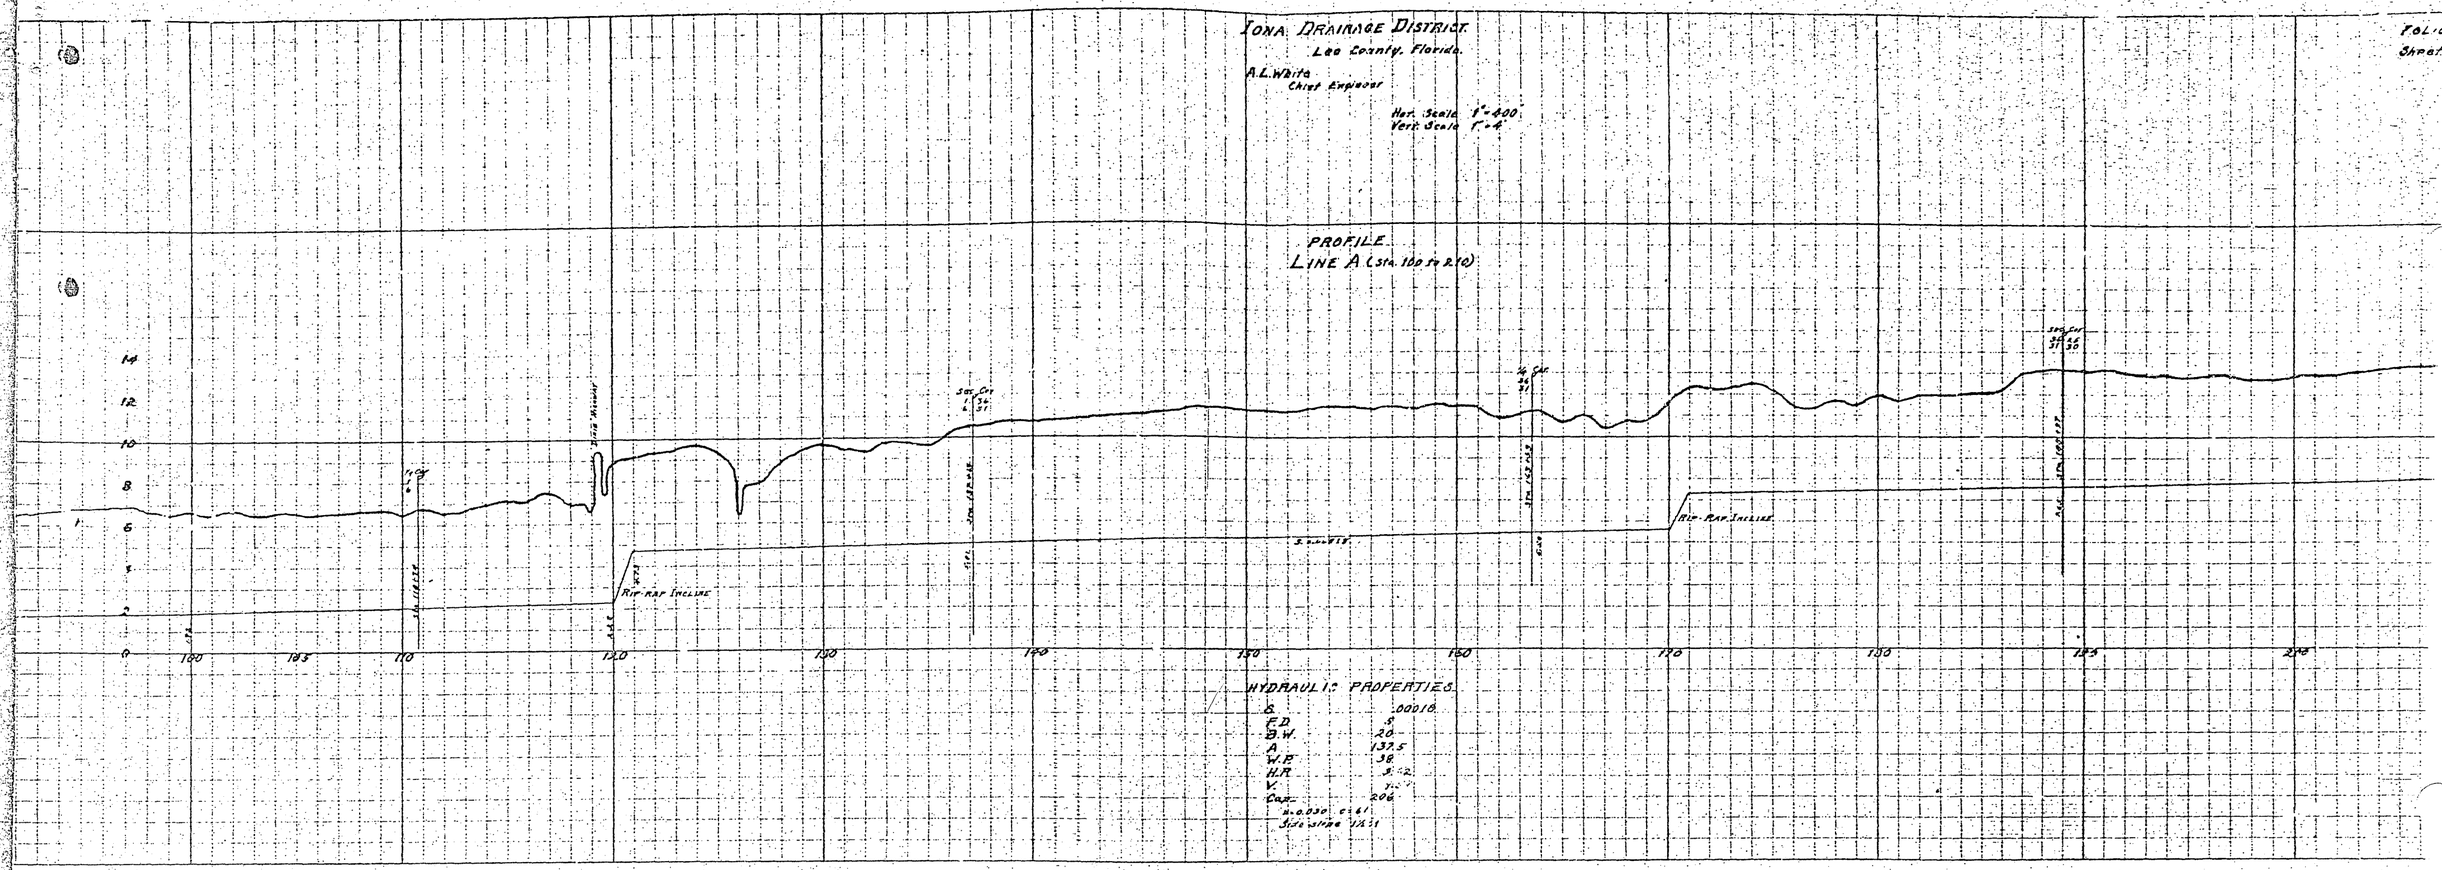
14
12
10
8
6
5
2
0
100
110
120
130
140
150
160
170
180
190
200
210
Rip-Rap Incline
Rip-Rap Incline


IONA DRAINAGE DISTRICT

Lee County, Florida

A.L. White,
Chief Engineer

Hor. Scale 1" = 400'
Vert Scale 1" = 4'

PROFILE
LINE A, (Sta. 200 to 310)

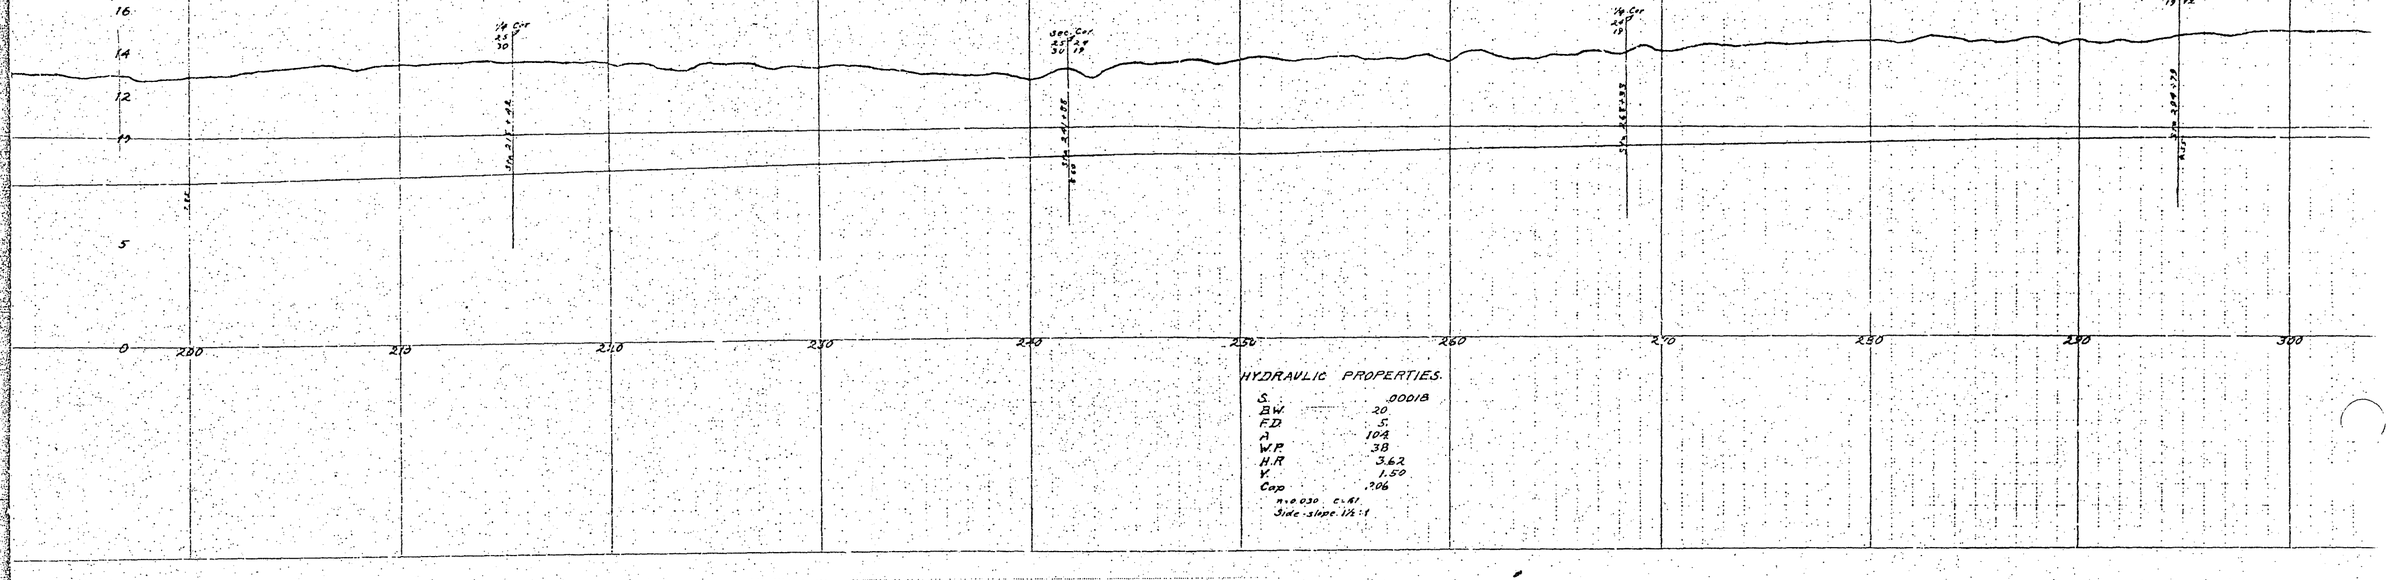


HYDRAULIC PROPERTIES.

S	.0018
BW	20
FD	5
A	104
W.P.	38
H.R	3.62
V.	1.50
Cap	206

n = 0.030 C = 61
Side slope 1½ : 1

PLAN
LINE A, Sta 200 to 310.

S. ⟵ ⟶ N.

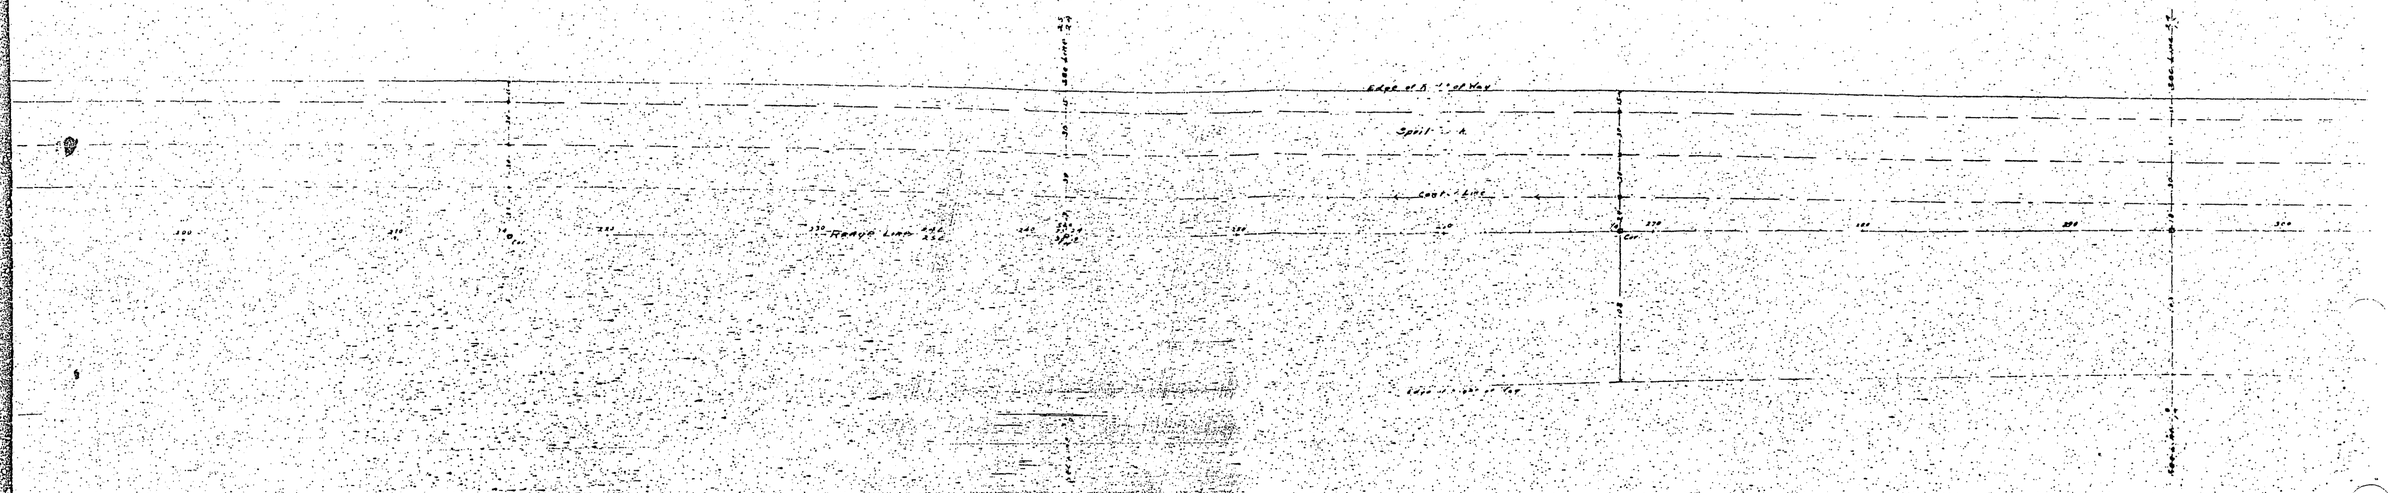

LONA DRAINAGE DISTRICT


Lee County, Florida.

A. L. White
Chief Engineer

Folio B
Sheet 4

Hor. Scale 1" = 40'
Vert. Scale 1" = 4'

PROFILE
LINE A (Sta. 300 to 410)

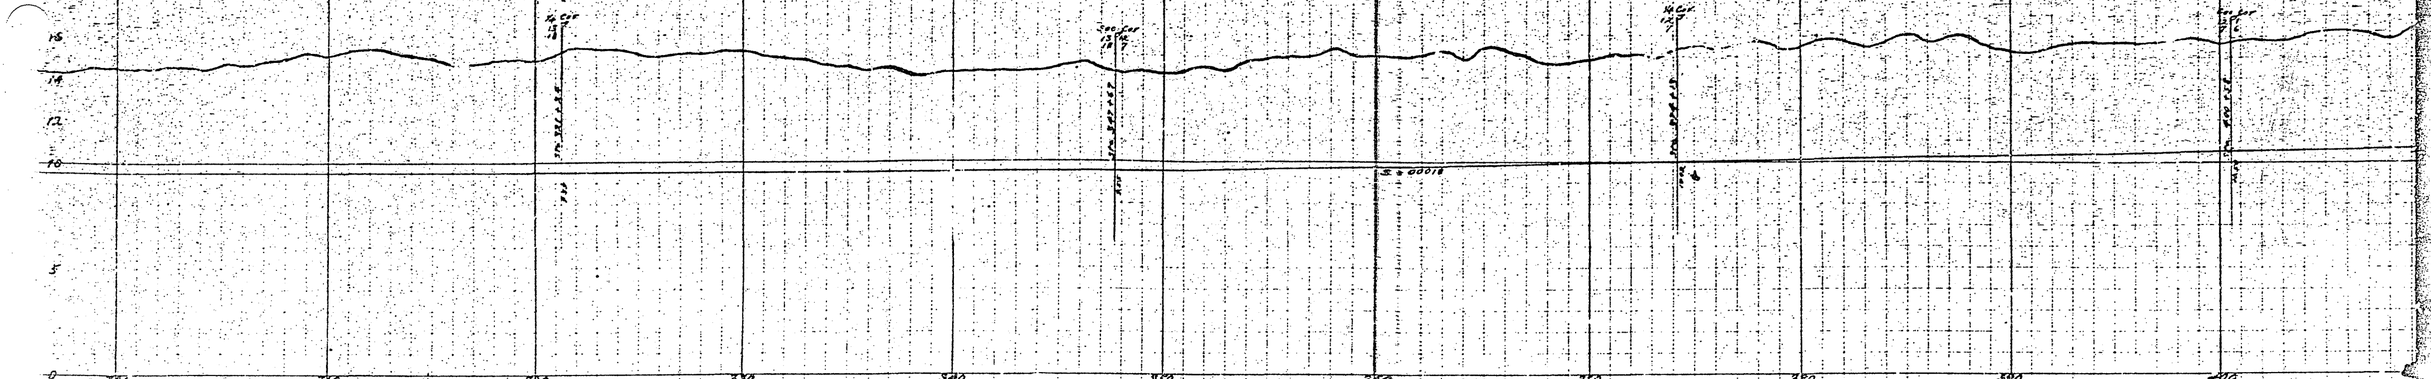

HYDRAULIC PROPERTIES.


S.	.00018
F.D.	5.
B.W.	28
A.	137.5
W.P.	38
H.R.	3.62
V.	1.50
Cap.	206

n. 0.030 d. 6'
Side slope 1½:1

Dec. 20, 1

PLAN
LINE A, Sta. 300 to 410

S ⟷ N

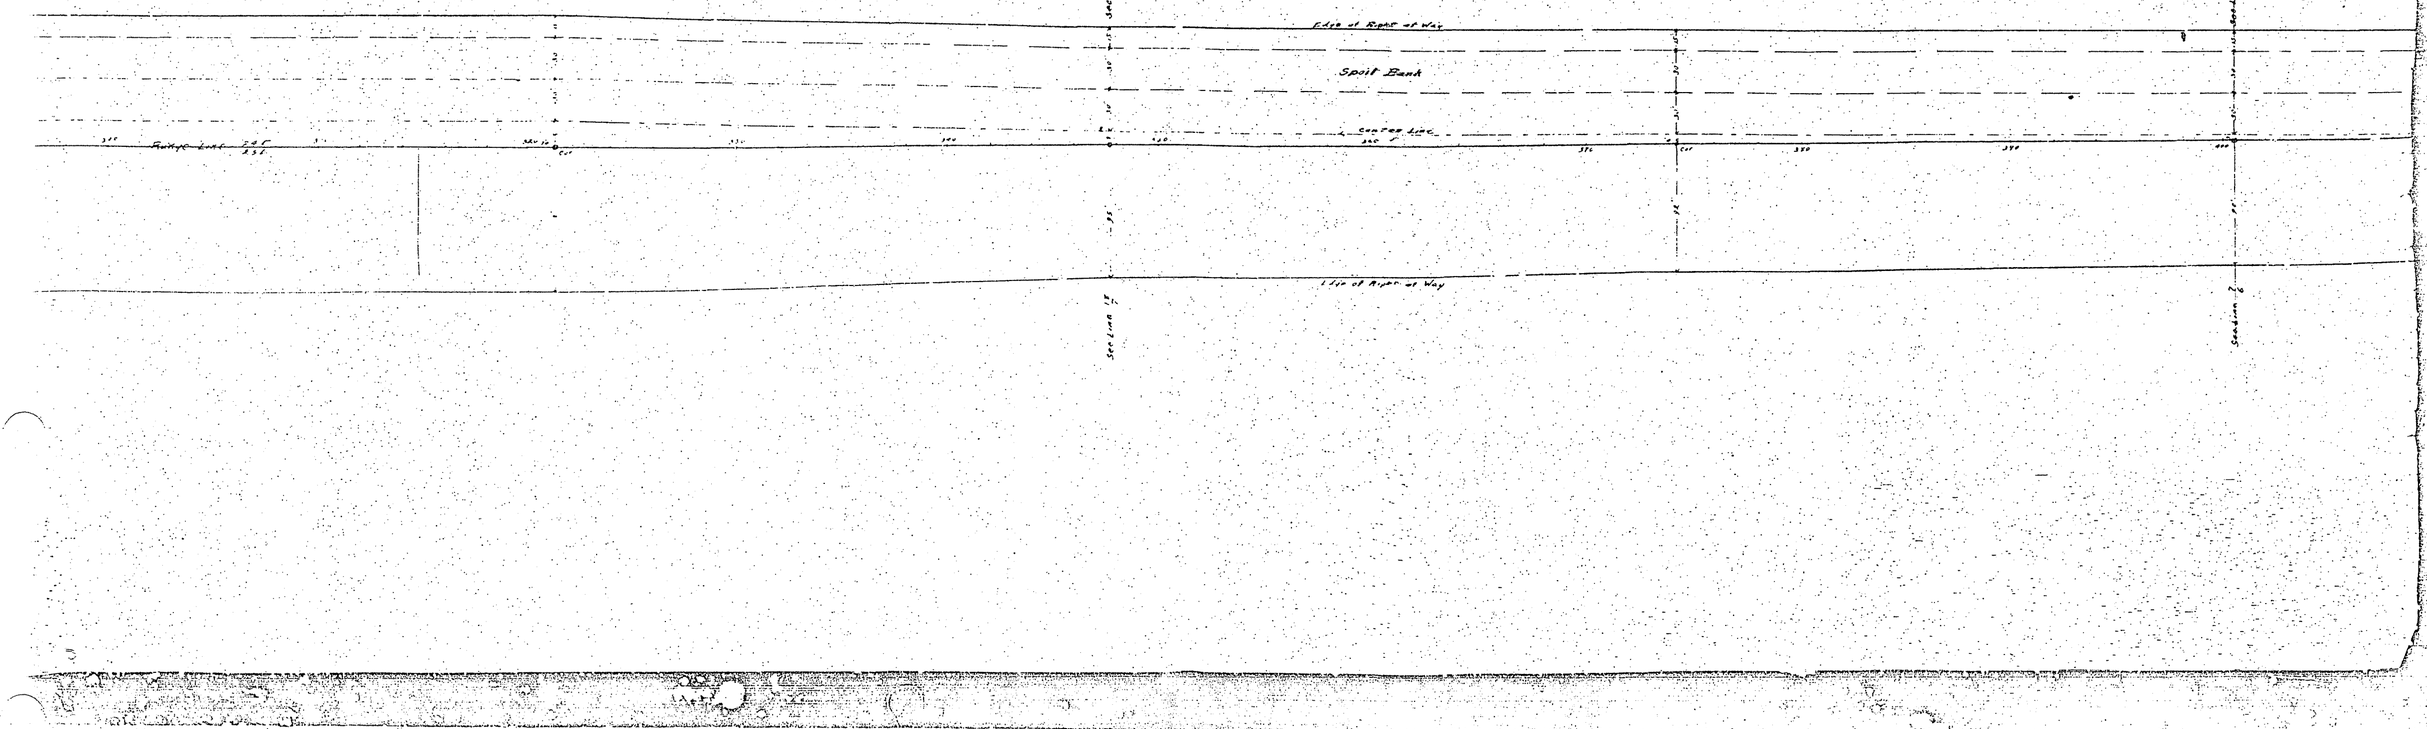

LONA DRAINAGE DISTRICT


Lee County, Florida

A. L. White
Chief Engineer

Hor. Scale 1" = 40ft.
Vert. Scale 1" = 4'

Folio B
Sheet 5

PROFILE
LINE A (Sta. 400 to 510)

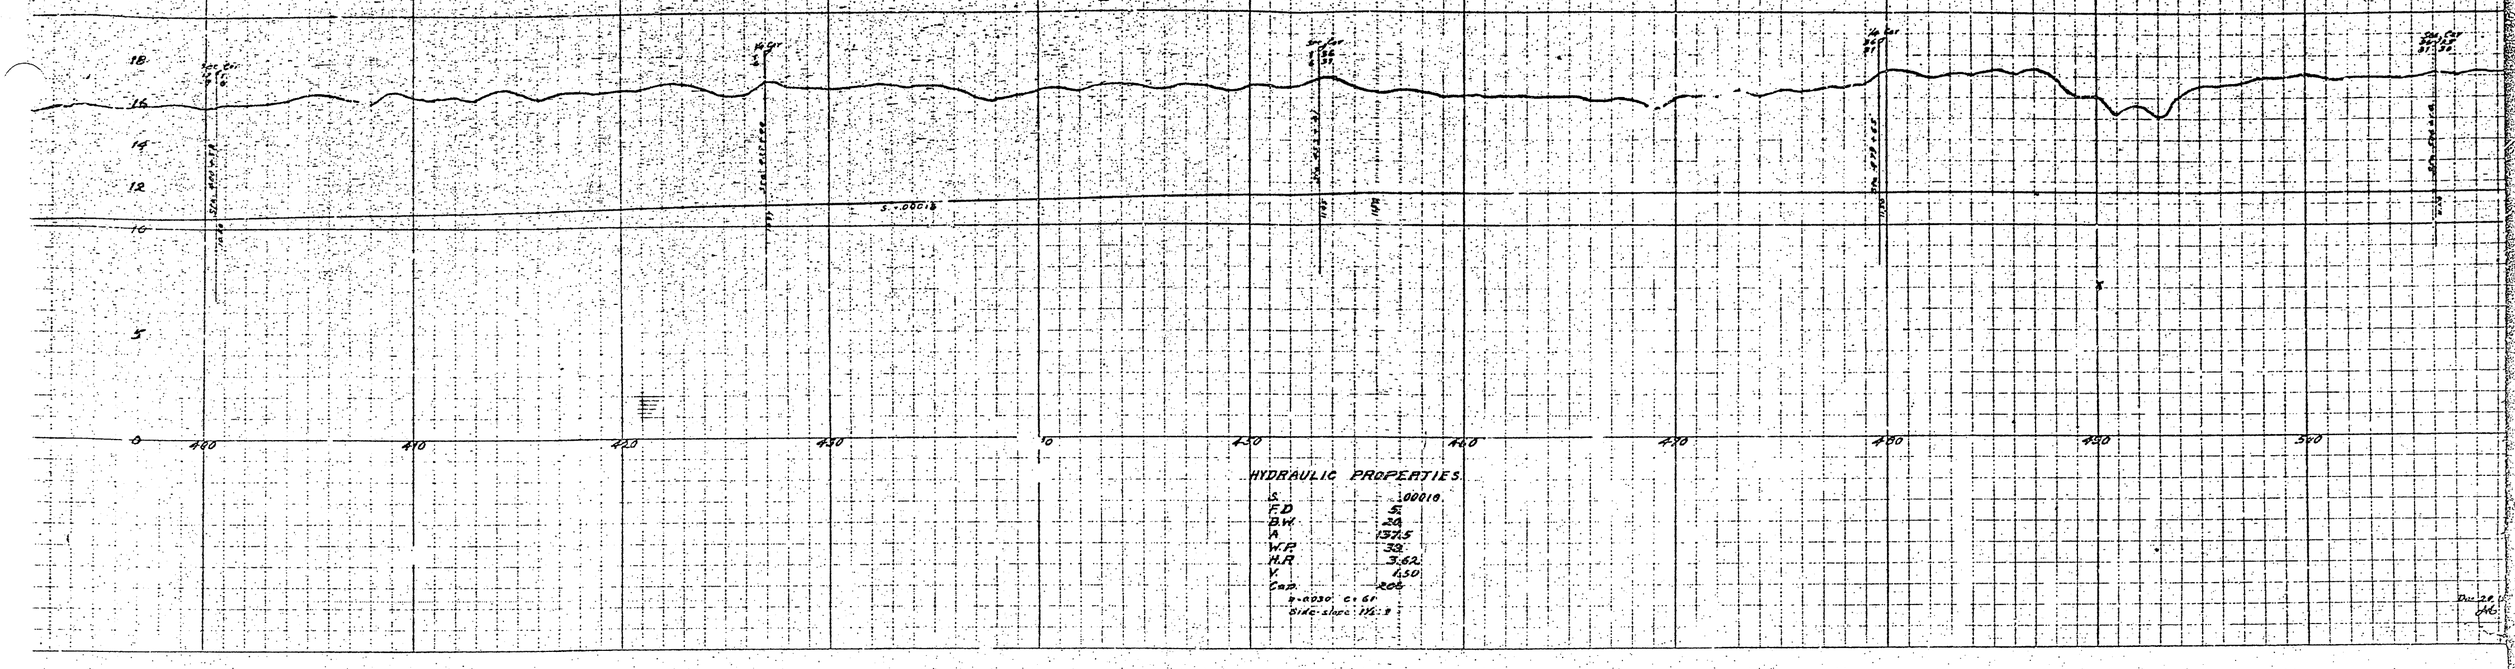
18
16
14
12
10
8
0
400
410
420
430
10
450
460
470
480
490
500
510
S. .0001 ft







HYDRAULIC PROPERTIES.



FOLIO
(Blank)

PLAN
LINE A, Sta. 500 to 584+82

S. ⟵ ⟶ N.


Edge of Right of Way
Spoil Bank
Range Line
Center Line
A
Edge of Right of Way
Edge of Right of Way
Spoil Bank
Center Line
A
Edge of Right of Way

IONA DRA. AG. DISTRICT
Lee County, Florida.
A. L. White,
Chief Engr.

Scale 1" =
Vert. Scale 1" =

Folio B-
Sheet 7.

PROFILE
LINE B.

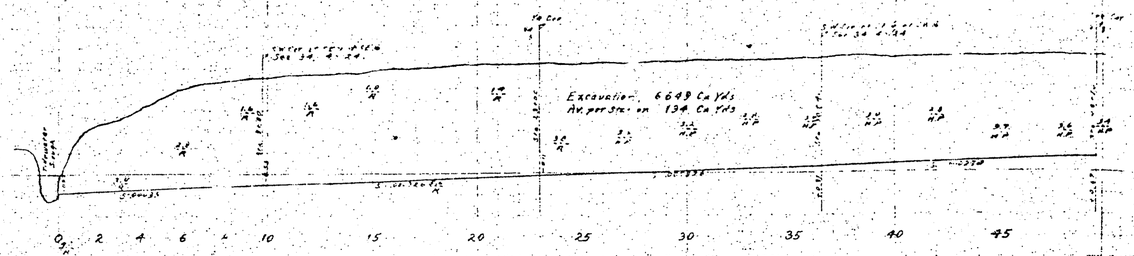

HYDRAULIC PROPERTIES.

S.	.00035
F.D	3.
B.W.	4.
A.	18.
W.P.	12.97 11.2
H.R.	1.32 1.61
V.	1.08 1.21
Cap.	19.45 21.8

n = .0035 c = 68.61
Side-slope 2:3

HYDRAULIC PROPERTIES.

S.	.000326
F.D.	3.
B.W.	4.
A.	18.
W.P.	13.91 11.2
H.R.	1.37 1.61
V.	0.925 1.14
Cap.	17.75 20.5


n = .0035 c = 65.50
Side slope - 2:3

HYDRAULIC PROPERTIES.

S.	.000274
F.D.	3.
B.W.	4.
A.	18.
W.P.	13.34 11.2
H.R.	1.35 1.6
V.	0.793 1.05
Cap.	14.3 18.9

n = .0035 c = 58.50
Side-slope - 2:3

PROFILE
LINE B1a.

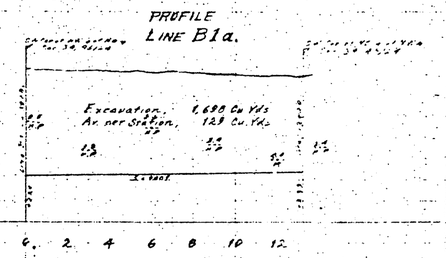

HYDRAULIC PROPERTIES.

S.	.000148
F.D	3.
B.W.	4
A.	18
W.P.	13.84 11.2
H.R	1.39 1.61
V.	0.675 0.76
Cap.	12.11 13.7


n = 0.035 c = 47.41
Side-slope 2:3

HYDRAULIC PROPERTIES.


S.	.0001
F.D	3.
B.W.	4.
A.	18.
W.P.	12.84 11.2
H.R.	1.39 1.61
V.	0.553 0.62
Cap.	9.5 10.1

n = 0.035 c = 47.41
Side slope 2:3

PROFILE
LINE B1

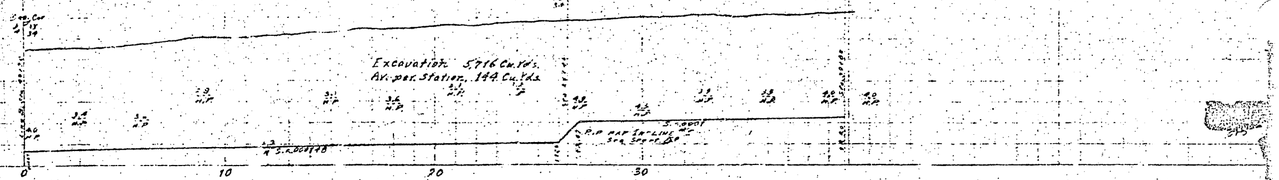


PLAN
LINE B

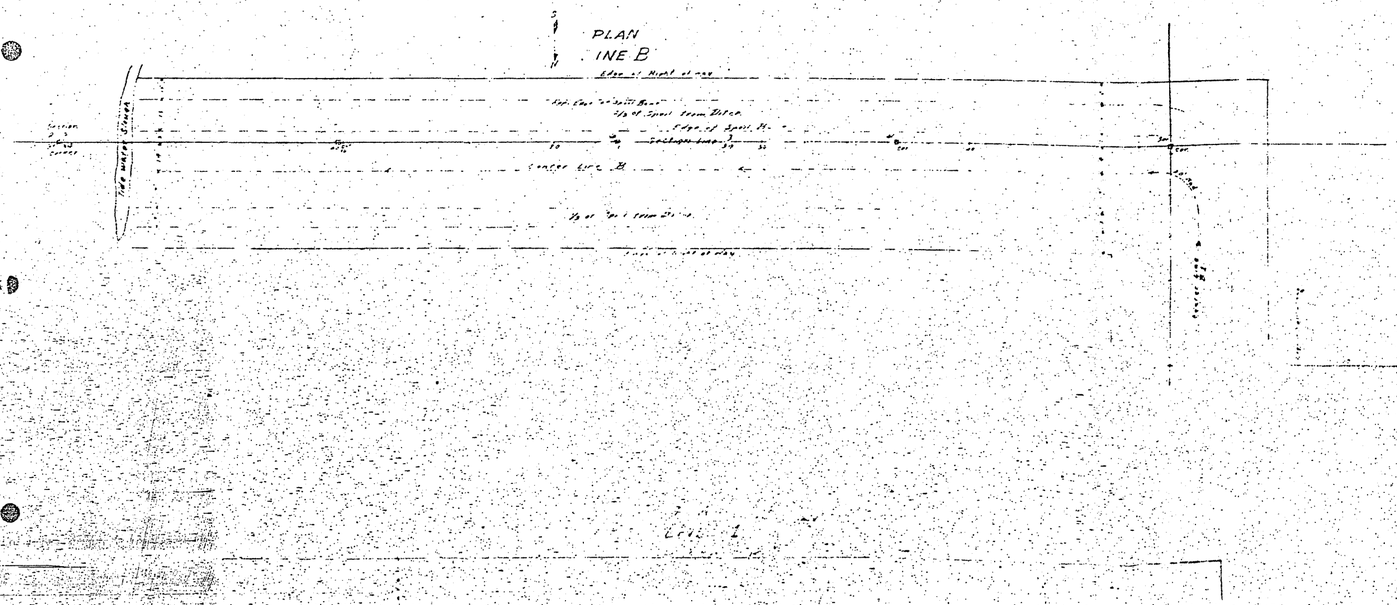

TYPICAL CROSS SECTION
OF ALL 4 BW
DITCHES
Scale 1" =

PLAN
LINE B1a

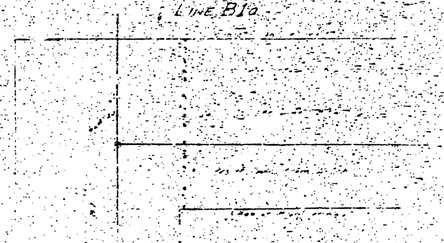

IONA DRAINAGE DISTRICT

Lee County, Florida

A. L. White, Chief Engineer


Folio E

Sheet 8

Hor. Scale 1" = 400
Vert. Scale 1" = 4'

PROFILE LINE C.

Sta. 0 to 119+50

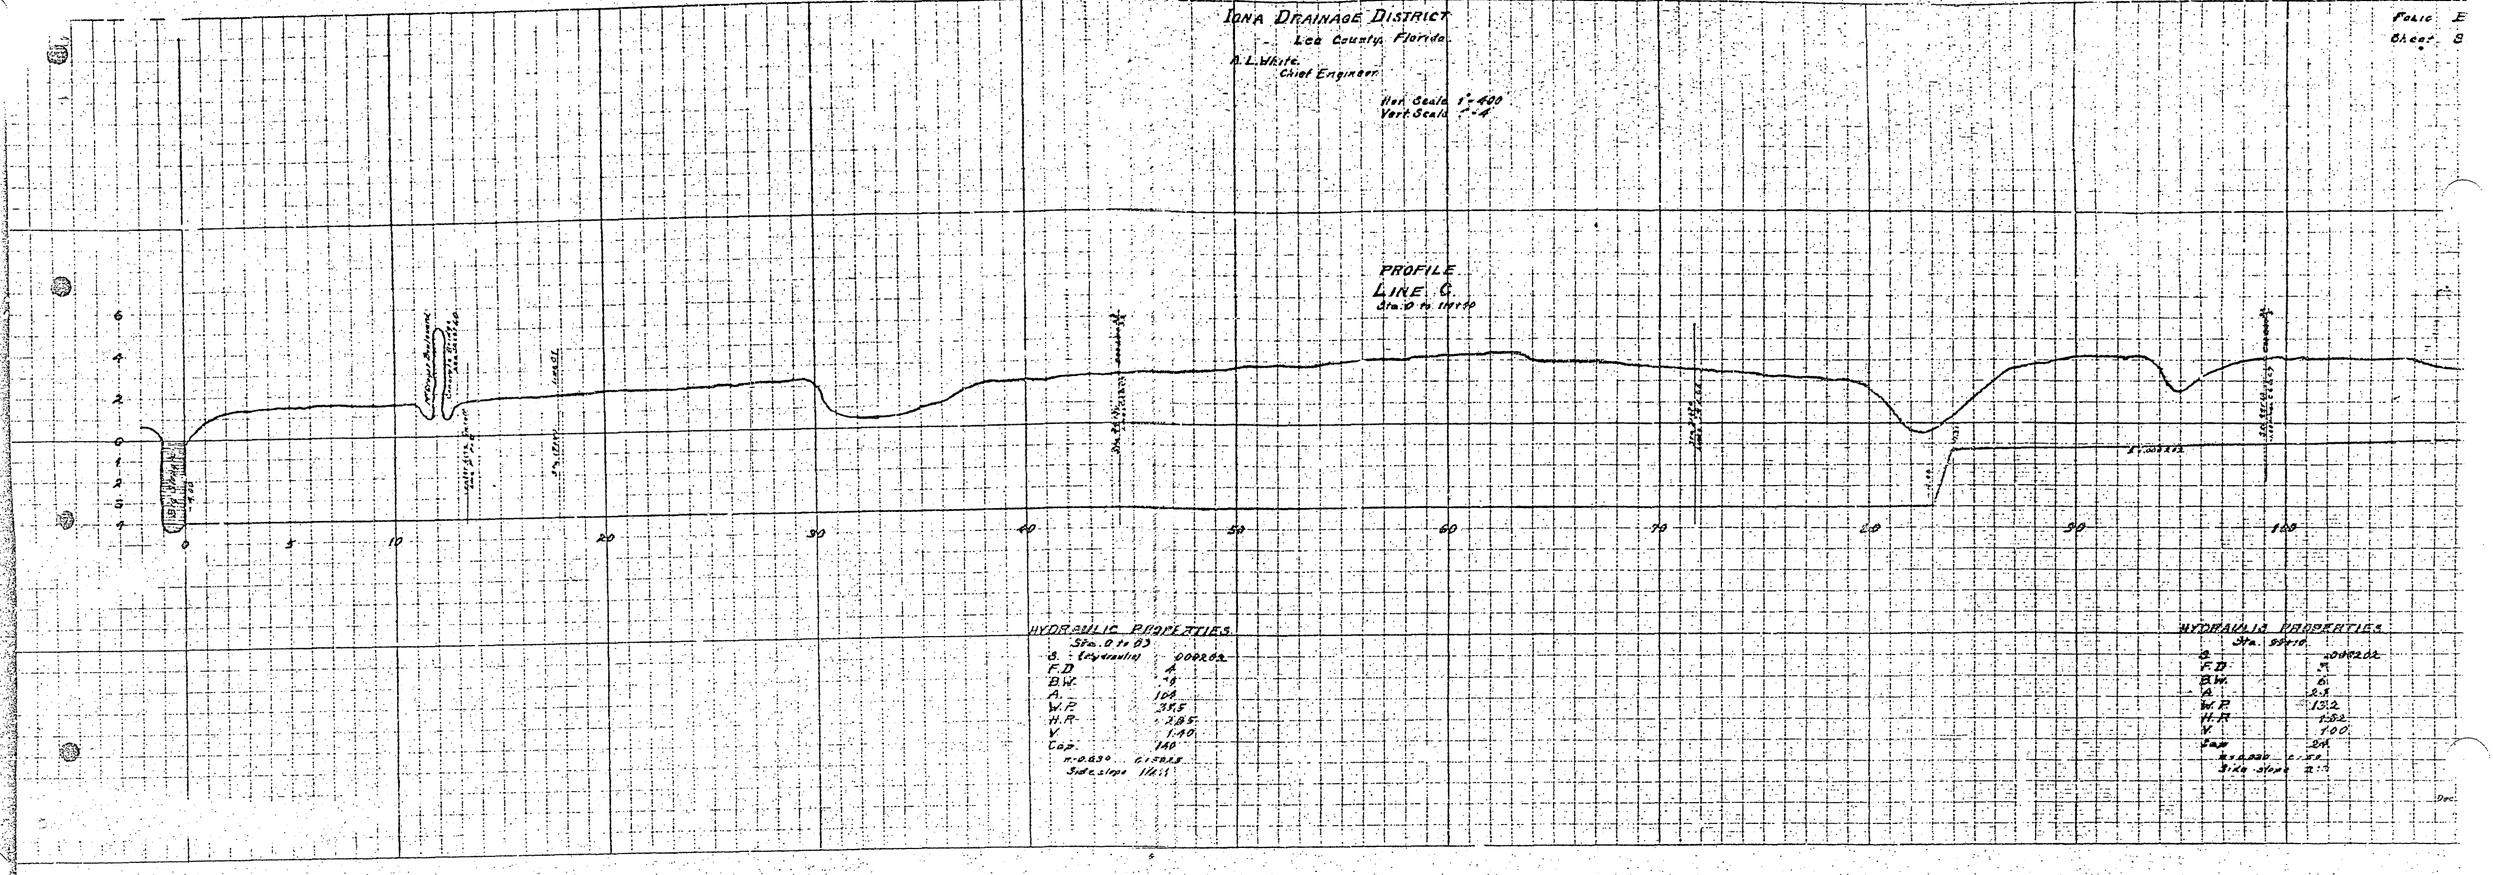
6
4
2
0
1
2
3
4
0
5
10
20
30
40
50
60
70
80
90
100
Big Slough
Ex. Ground
Ex. Ground
Ex. Ground

STANDARD PROFILE PLATT A 4X10

IONA DRAINAGE DISTRICT


Lee County, Florida.

A. L. White,
Chief Engineer


Hor. Scale 1" = 100'
Vert. Scale 1" = 4'

PROFILE LINE C

Sta. 110 to 152+20

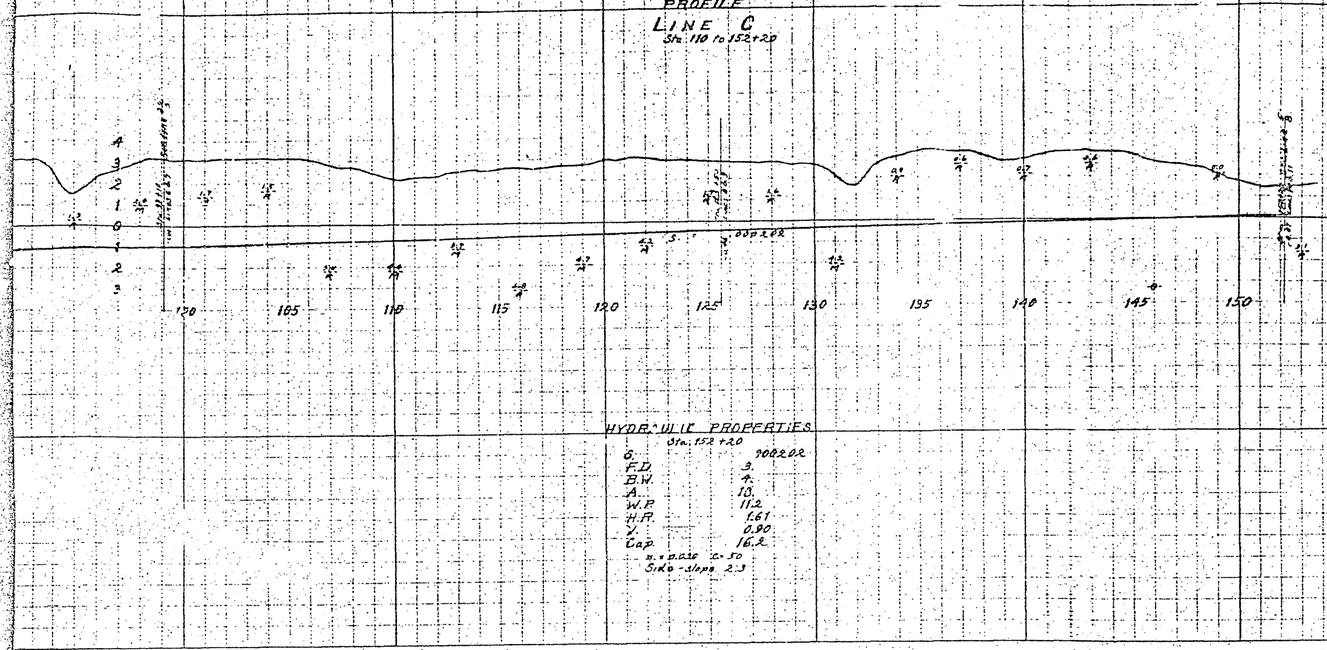

PROFILE CUTOFF

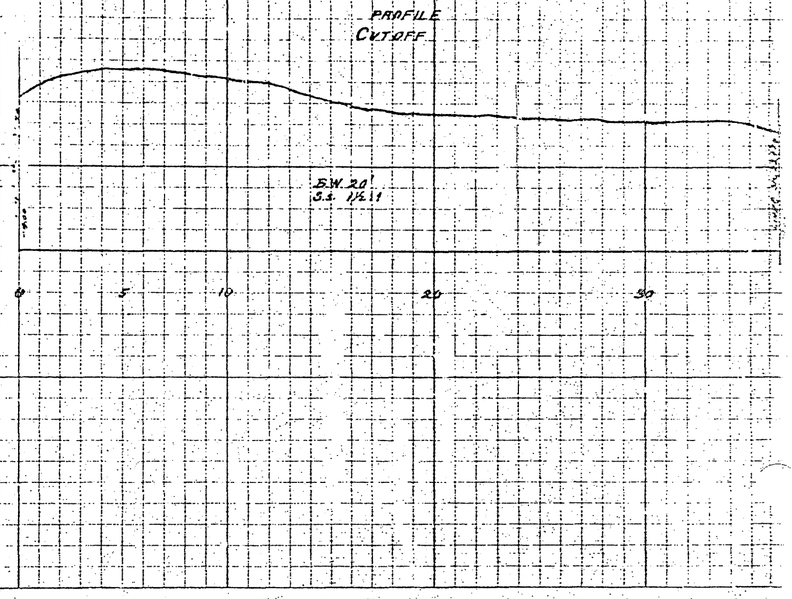


HYDRAULIC PROPERTIES

Sta. 152+20


Q.		3.	900.202
F.D.		3.	
B.W.		4.	
A.		13.	
W.P.		11.2	
H.R.		1.61	
V.		0.90	
Cap.		16.2	

n. = 0.030 C = 50
Sike - slope 2.3

PLAN LINE C.

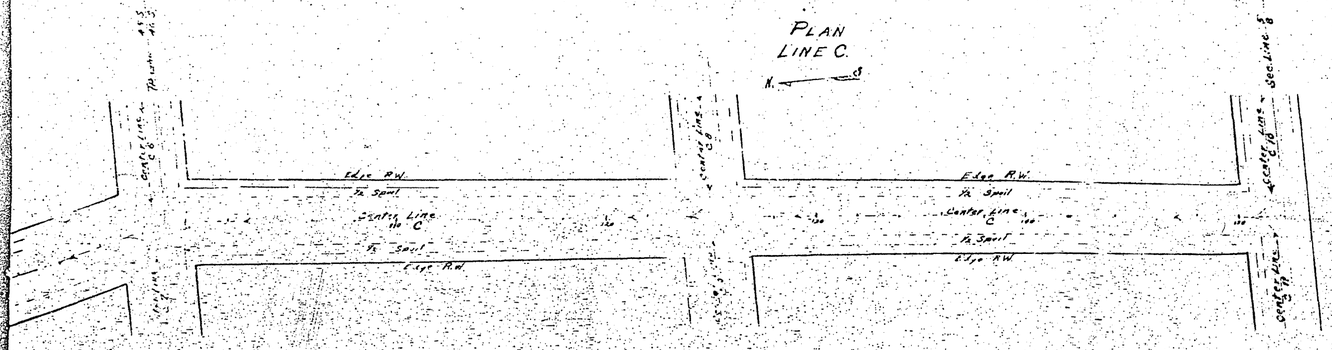

PLAN CUTOFF

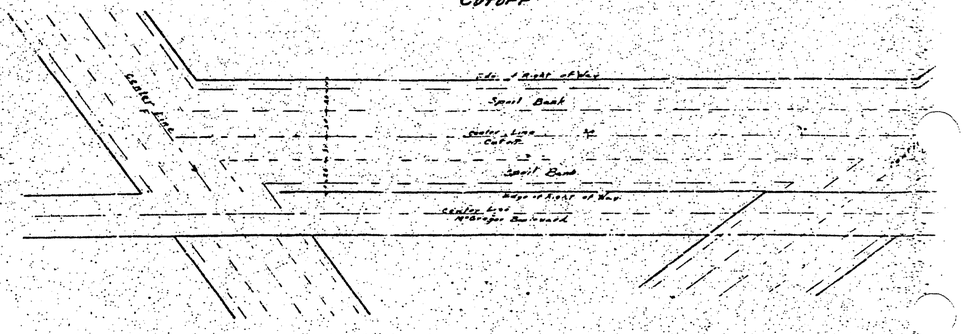

Iona Drainage District

Lee County, Florida


A. L. White, Chief Engineer

Folio B

Sheet 9

Hor. Scale 1" = 400'
Vert. Scale 1" = 4'

PROFILE LINE C1

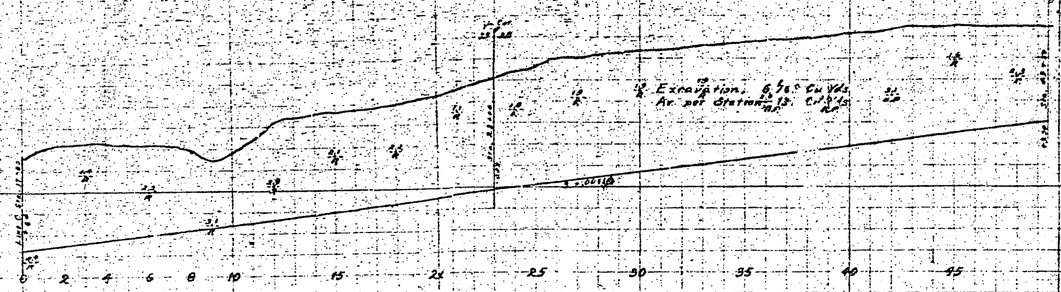


HYDRAULIC PROPERTIES

S.	.00114
F.D.	1.65
B.W.	4.
A.	8.41
W.P.	7.96
H.R.	1.06
V.	1.58
Cap.	13.3

n = 0.030 c = 45.6
Side-Slope 2:1

PROFILE LINE C2

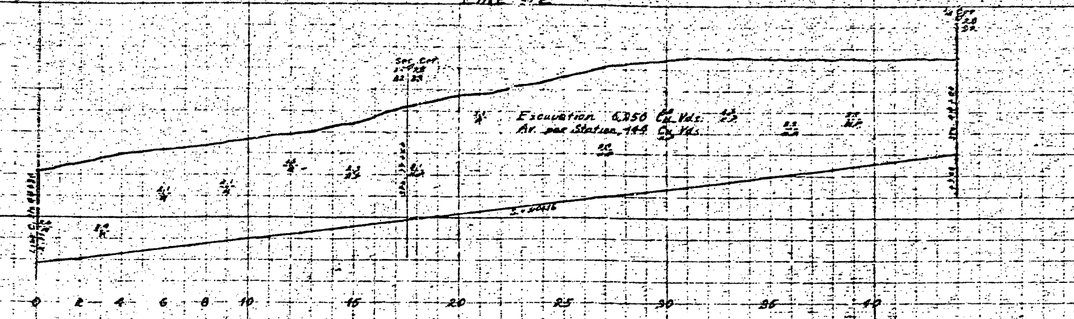


HYDRAULIC PROPERTIES


S.	.00116
F.D.	1.65
B.W.	4.
A.	8.41
W.P.	7.96
H.R.	1.06
V.	1.60
Cap.	13.46

n = 0.030 c = 45.8
Side-slope 2:1

PLAN LINE C1.

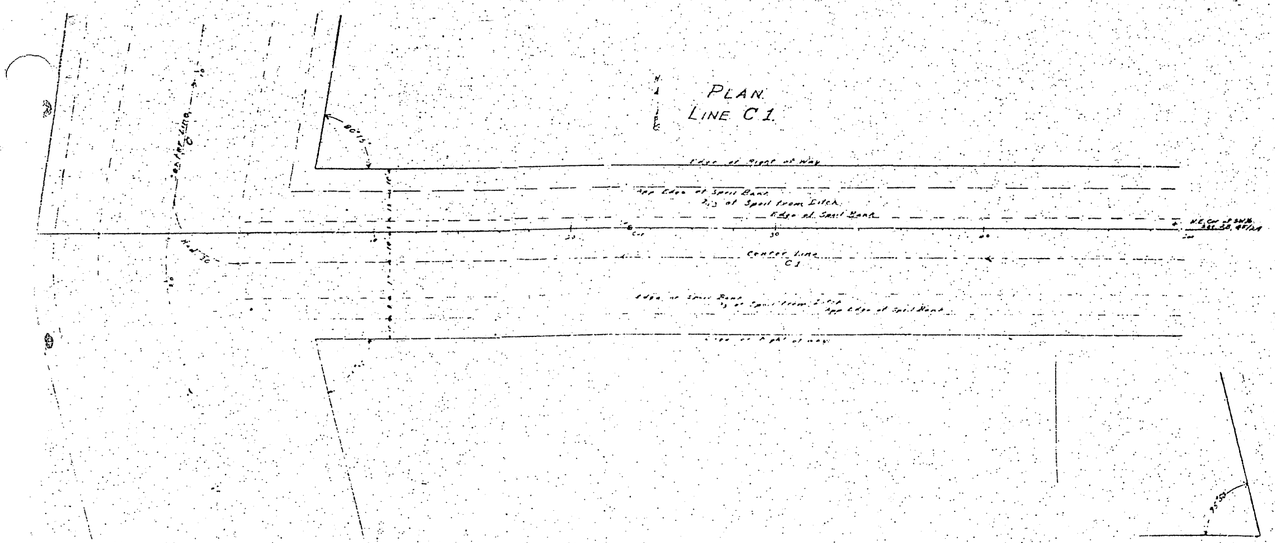

PLAN LINE C2.

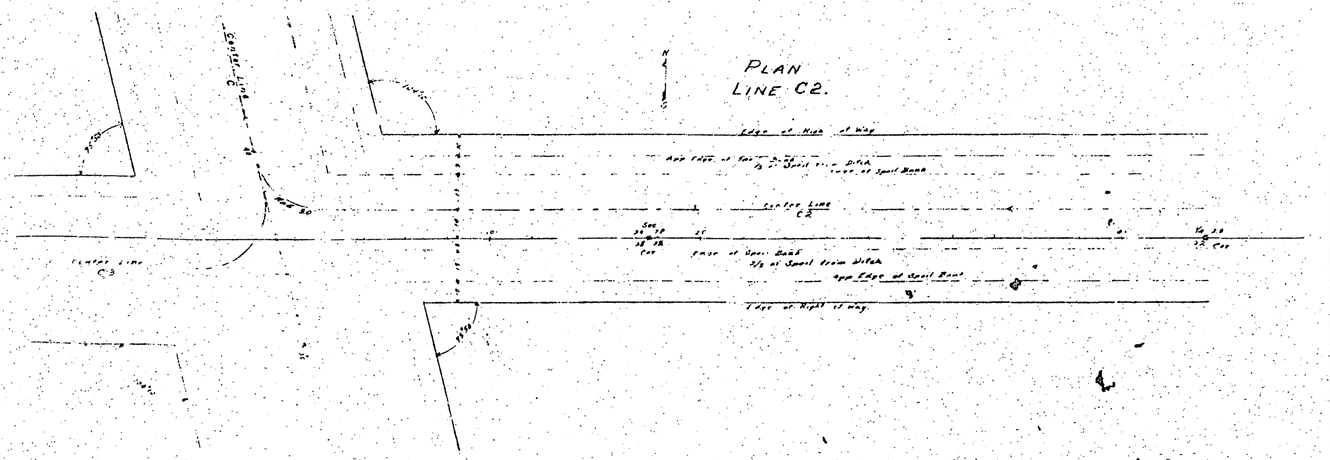

IONA DRAINAGE DISTRICT


Lee County, Florida.

A.L. White, Chief Engineer.

Hor. Scale 1" = 400'
Vert. Scale 1" = 4'

Field B.
Sheet 10.

PROFILE LINE C3.

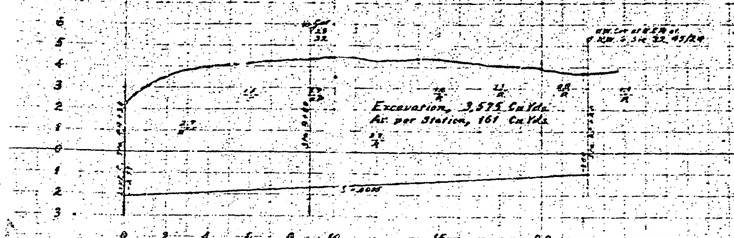


HYDRAULIC PROPERTIES.

S.	.0030
F.D.	3.
B.W.	4.
A	18.
W.P.	12.96 11.2
H.R.	1.39 1.61
V.	1.30 1.45
Cap.	# 26.1

n = 0.030 (-45 #)
Side slopes 2:1.

PROFILE LINE C4.

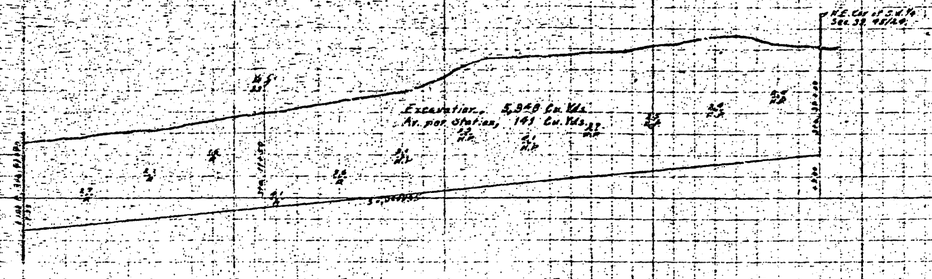


HYDRAULIC PROPERTIES.


S.	.00935
F.D.	1.5
B.W.	4.
A	7.5
W.P.	7.6
H.R.	0.99
V.	1.37
Cap.	10.3

n = 0.030 (-45
Side-slope 2:1

PLAN LINE C3.

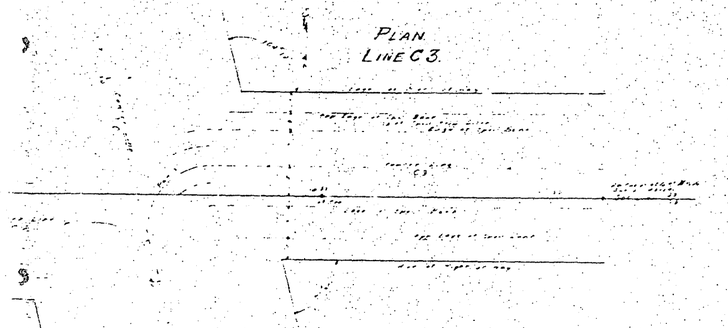

PLAN LINE C4.

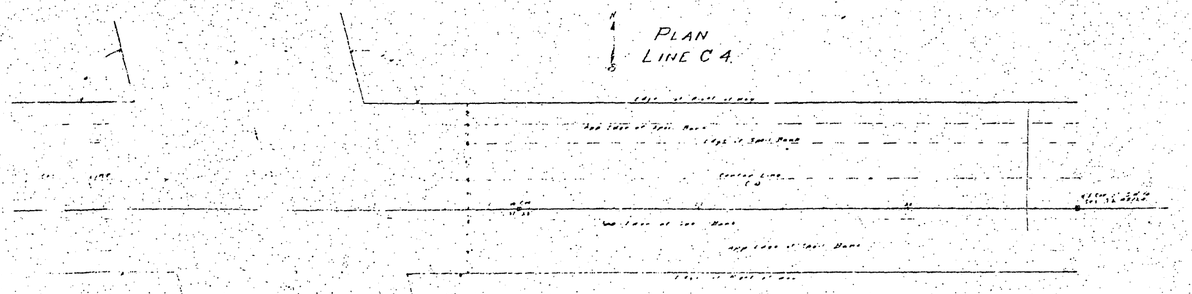

ONA DRAINAGE DISTRICT


Lee County, Florida.

A. L. White, Chief Engineer.

Folio D
Sheet 11

Hor. Scale 1" = 100'
Vert. Scale 1" = 4'

PROFILE
LINE C 5.

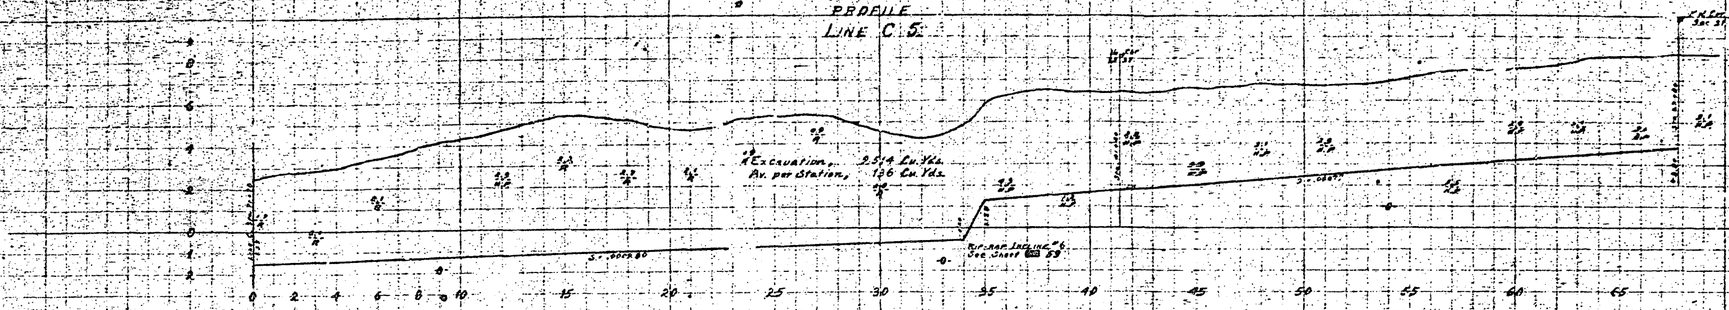

HYDRAULIC PROPERTIES

S.	.00248.	
F.D	3.	
B.W.	4.	
A.	16.	
W.P.	12.94	11.2
H.R.	1.39	1.61
V.	4.853	5.04
Cap.	77.3	19.2


n = .0030 c = 85.59
Side-slope 2 : 1

HYDRAULIC PROPERTIES

S.	.00077.
F.D	1.5
B.W.	4.
A.	7.5
W.P.	7.6
H.R.	0.99
V.	1.24
Cap.	9.3

n = .0030 c = 45
Side-slope 2:1.

PLAN
LINE C 5.

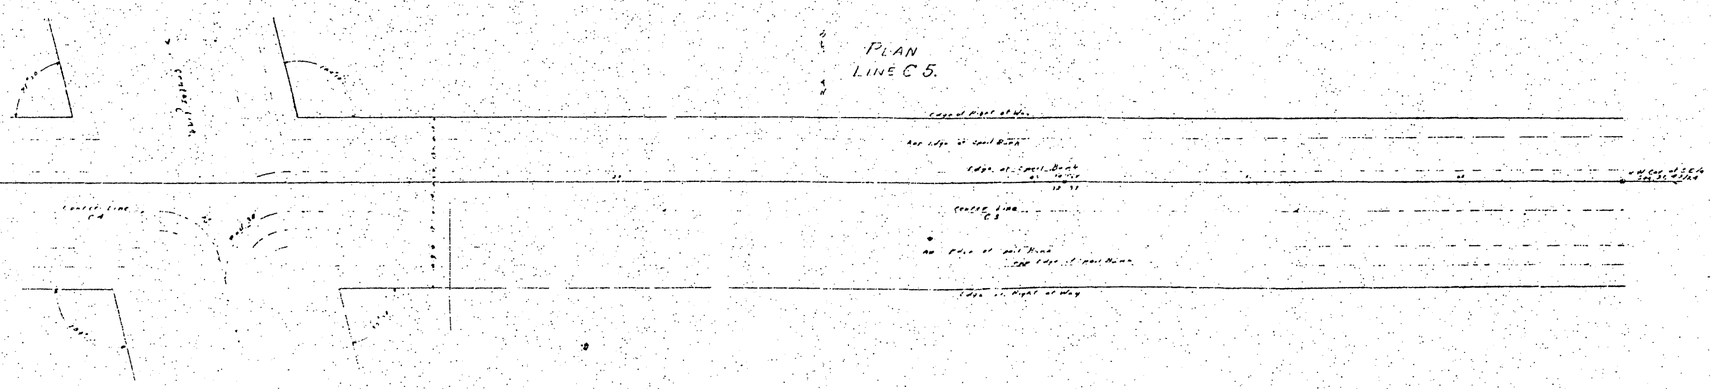

IONA DRAINAGE DISTRICT


Lee County, Florida.

A. L. White
Chief Engineer.

Hor. Scale 1" 400
Ver. Scale 1" 4'

FOLIO B
SHEET 12.

PROFILE.
LINE C 6.

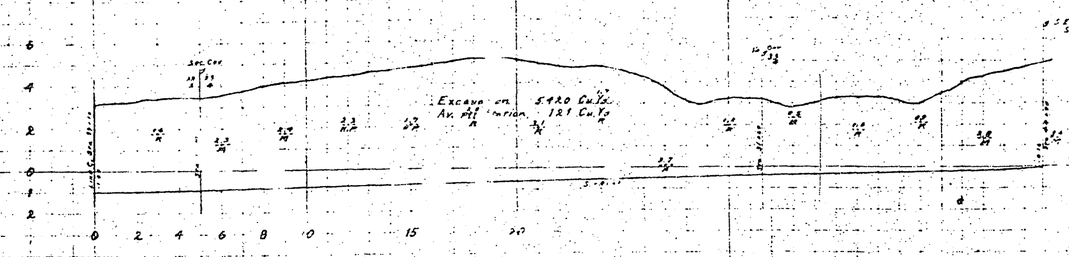


HYDRAULIC PROPERTIES.

L	.0002	
F.D.	.3.	
D.H.	4.	
A	18.	
W.P.	12.96	11.2
H.R.	1.39	1.61
V.	0.89	0.90
Cap.	16	20

n : 0.030 c : 48.50
Cut-slope 2:1

PLAN
LINE C 6.

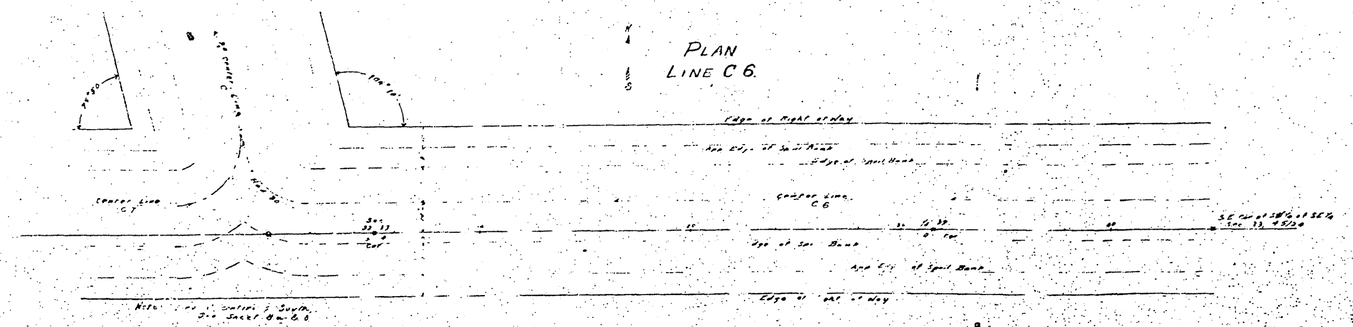


IONA DRAINAGE DISTRICT
Lee County, Florida
A.L. White
District Engineer

Hor. Scale 1" = 40
Vert. Scale 1" = 4

Solid [illegible]
Sheet 1.

PROFILE
LINE C 7

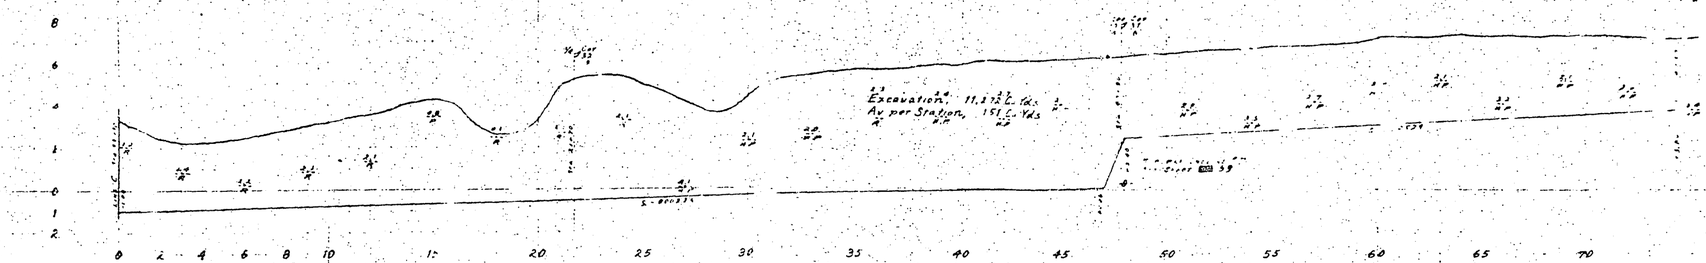

HYDRAULIC PROPERTIES

S.	.000225	
F.D.	3	
B.W.	4	
A.	10.	
W.P.	12.98	11.2
H.R.	1.03	1.61
V.	0.85	0.95
Cap.	15.3	17.1


n = 0.035 c = 48.50
Side slope 2:3

HYDRAULIC PROPERTIES

S.	.000529	
F.D.	3.	
B.W.	4	
A.	18.	
W.P.	12.74	11.2
H.R.	1.39	1.61
V.	1.33	1.48
Cap.	25.9	26.6

n = 0.030 c = 49.51
Side slope 2:3

PLAN
LINE C 7

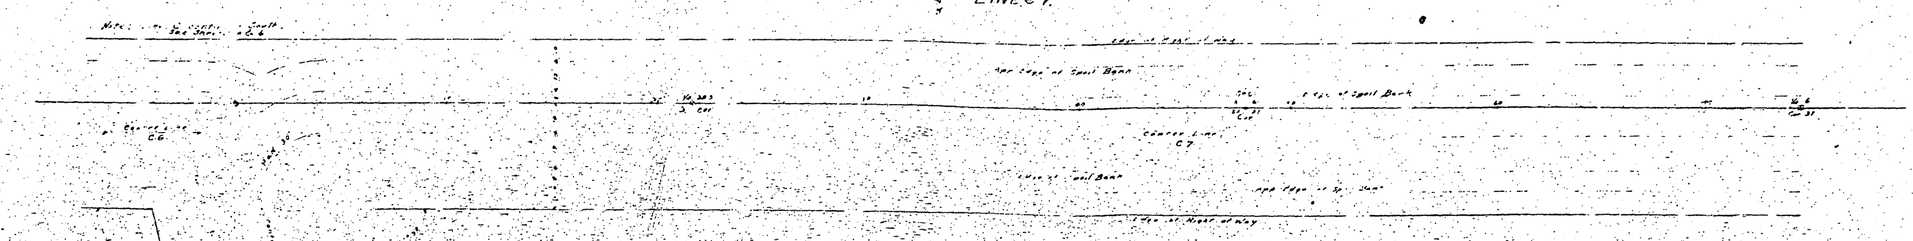

IONA DRAINAGE DISTRICT


Lee County, Florida.

A. L. White, Chief Engineer.

Hor. Scale 1" = 400'
Vert. Scale 1" = 4'

FOLIO B
SHEET 18

PROFILE LINE C8

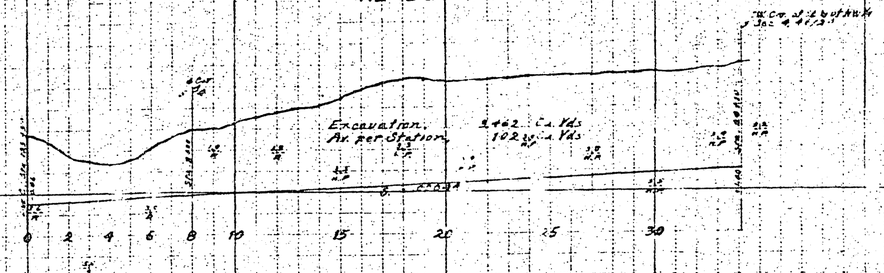


HYDRAULIC PROPERTIES

S.	.0049
F.D.	3'
B.W.	4'
A.	18.
W.P.	11.2
H.R.	1.61
V.	1.36
Cap.	24.4

n = 0.030 ; 1:1
Side slopes 2:1

PROFILE LINE C9

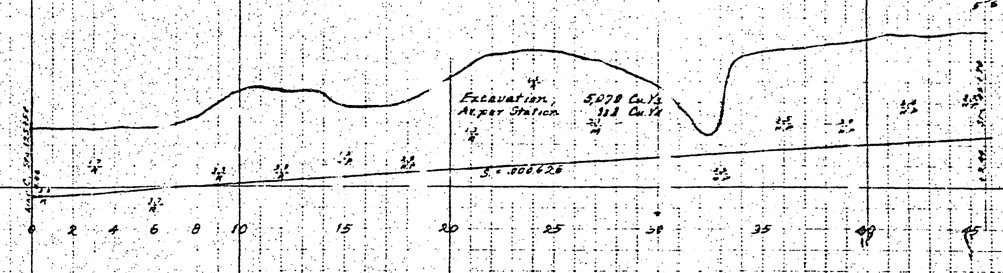


HYDRAULIC PROPERTIES

S.	.00626
F.D.	3'
B.W.	4'
A.	19
W.P.	11.2
H.R.	1.61
V.	1.62
Cap.	29.2

n = 0.030 1:1
Side slopes 2:1

PLAN LINES C8 & C9

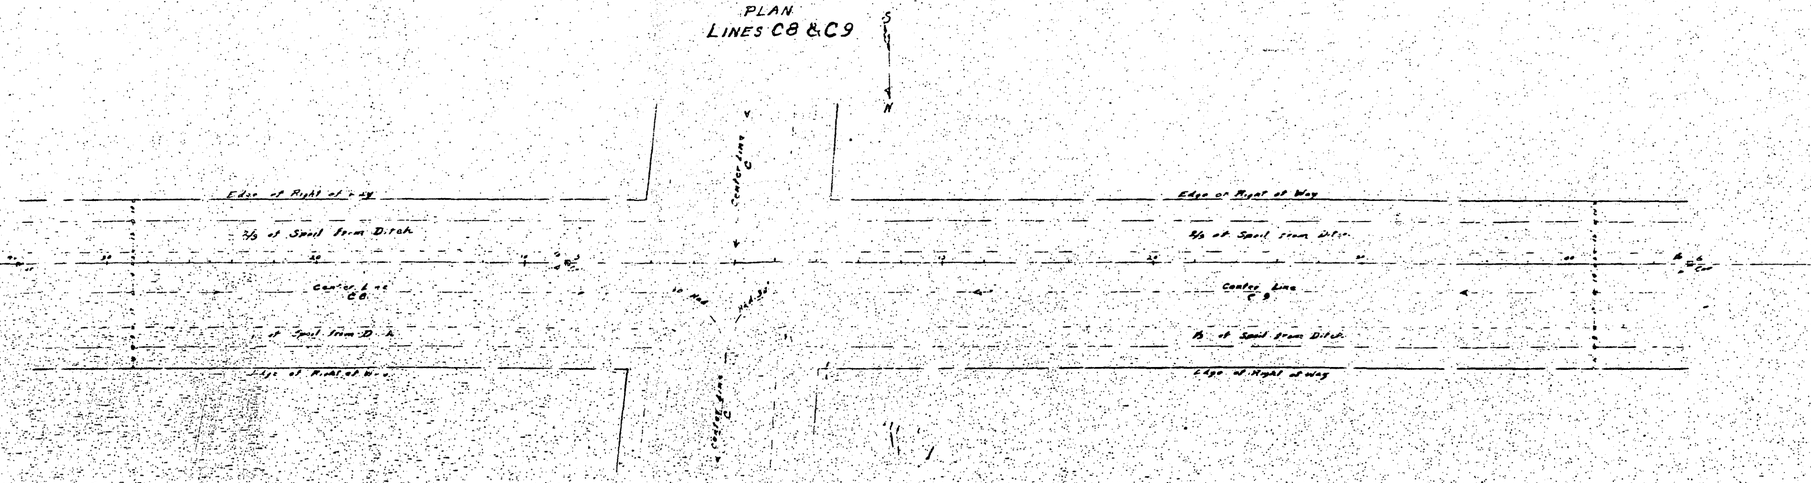


IONA DRAINAGE DISTRICT
Lee County, Florida
A. L. White,
Chief Engineer.

Hor. Scale 1"=400'
Vert Scale 1"=4'

Sheet

PROFILE
LINE D

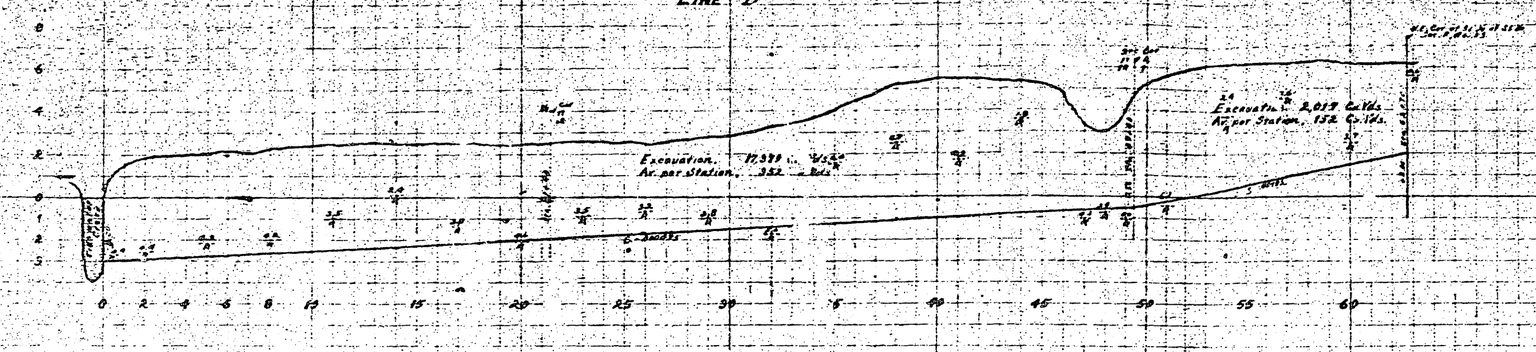

HYDRAULIC PROPERTIES

S.	.000495
F.D	3.
B.W.	4.
A.	39.
W.P.	23.96
H.R.	1.7
V.	1.50
Cap.	58.4


n.=0.30 c.=51.6
Side slope 3:1

HYDRAULIC PROPERTIES

S.	.00192
B.W.F.D	0.9
B.W.	4.
A.	4.14
W.P.	6.16
H.R.	0.67
V.	1.43
Cap.	5.9

n.=0.30 c.=40
Side slope 2:1

PROFILE
LINE D1

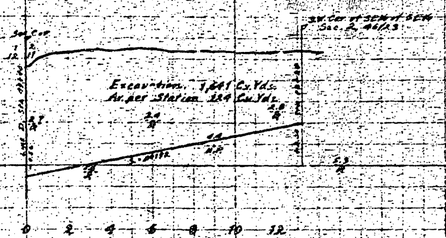


HYRAULIC PROPERTIES

S.	.00192
F.D	0.9
B.W.	4.
A	4.14
H.R. 0.67	W.P. 6.16
V.	1.43
Cap.	5.9

n.=0.30 c.=40
Side slope 2:1

PLAN
LINES D & D1

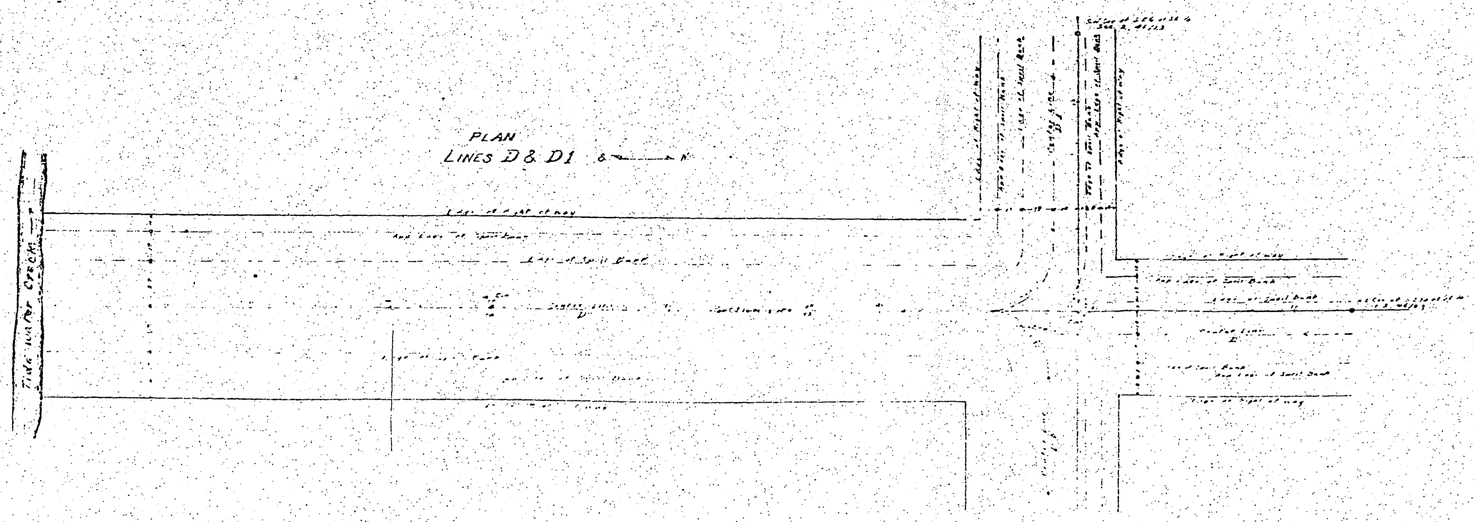

Lona Drainage District

Lee County, Florida

Lines
County Engineer

Hor. Scale 1" = 400'
Vert Scale 1" = 4'

Folio B
Sheet 15

PROFILE LINE C 10

Excavation, 4,241 Cu. Yds.
Av. per Station, 85 Cu. Yds.

S = .00187

HYDRAULIC PROPERTIES

S.	.00187
F.D.	3.
B.W.	4.
A.	12.
W.P.	11.2
H.R.	1.61
V.	0.87
Cap.	15.6

n = .0030 c = 51

PROFILE LINE C 11

Excavation, 4,957 Cu. Yds.
Av. per Station, 103 Cu. Yds.

S = .000311

HYDRAULIC PROPERTIES

S	.000311
F.D.	3.
B.W.	4.
A	18.
W.P.	11.2
H.R.	1.61
V.	1.14
Cap.	20.5

n = .0030 c = 51
Side slope 2:1

PLAN LINES C10 & C11.

Edge of Right of Way

⅓ of Spoil from Ditch

Center Line C 10

Center Line C 11

⅓ of Spoil from Ditch

Edge of Right of Way

IONA DRAINAGE DISTRICT


Lee County, Florida.

A. L. White,
Chief Engineer


Hor. Scale 1" = 40'
Vert Scale 1" = 4'

Folio B
Sheet 18

PROFILE
LINE D2a

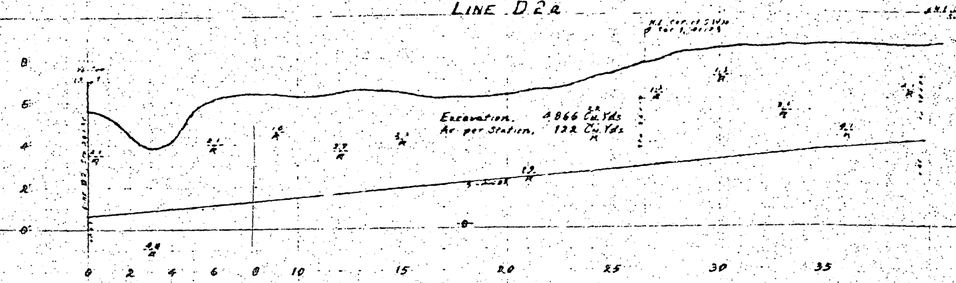

PROFILE
LINE D2c.

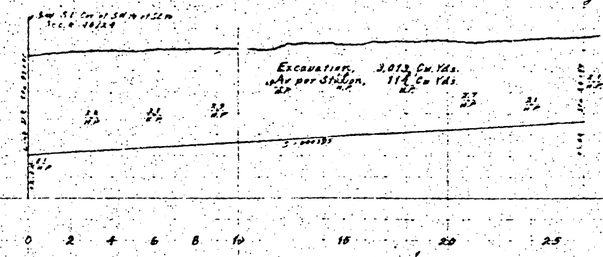

HYDRAULIC PROPERTIES.

S.	.0085
F.D.	1.5
B.W.	4.
A.	7.50
W.P.	7.60
H.R.	0.99
V.	1.30
Cap.	9.79


n = .0030 c = 45
Side slope 2:3

HYDRAULIC PROPERTIES.


S.	.000595
F.D.	3.
B.W.	4.
A.	18.
W.P.	~~11.35~~ 15.2
H.R.	~~1.39~~ 1.61
V	~~1.47~~ 1.58
Cap.	~~25.4~~ 28.4

n = 0.030 c = 49.57
Side slope 2:3

PLAN
LINE D2a.

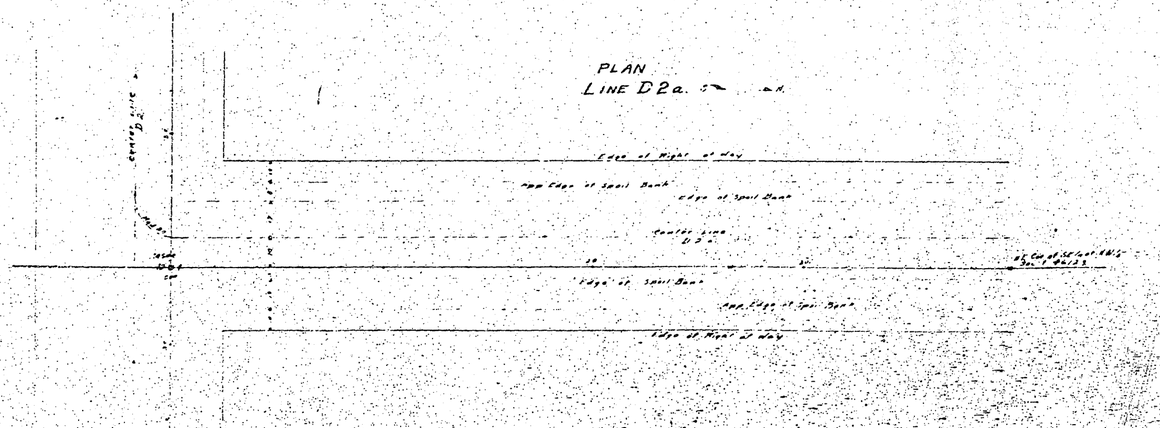

PLAN.
LINE D2c.

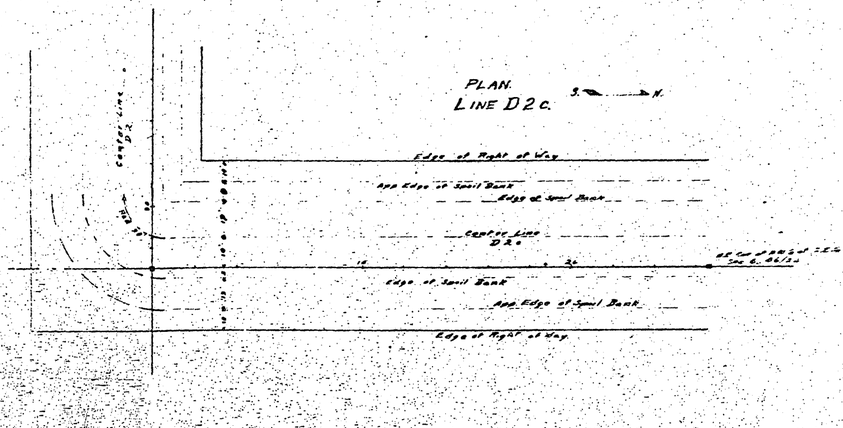

IONA DRAINAGE DISTRICT


Lee County, Florida.

A. L. White
Chief Engineer


Folio B.
Sheet 19

Hor. Scale 1"=400'
Vert. Scale 1"=4'

PROFILE
LINE D2 b.

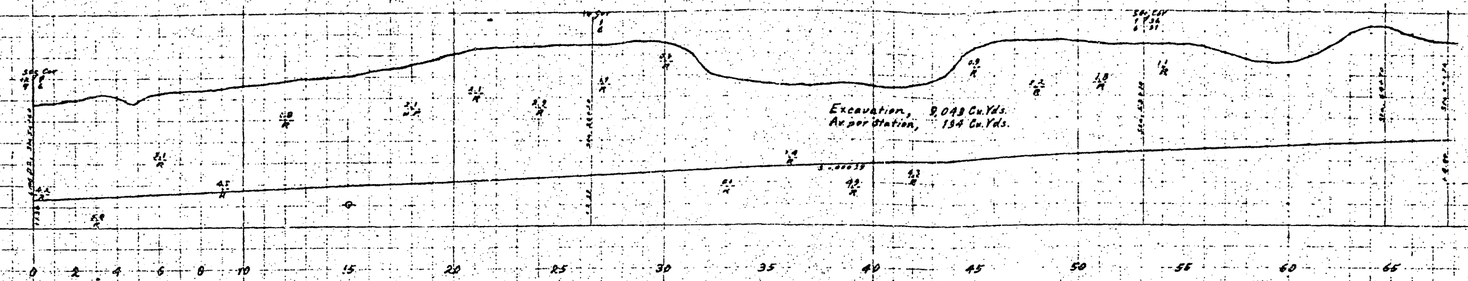

PROFILE
LINE D2 b1.

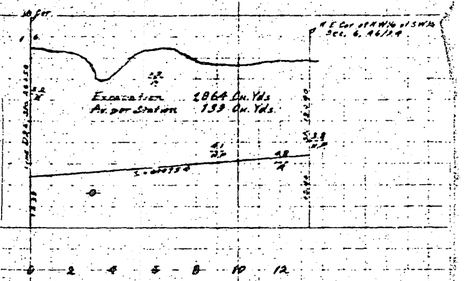

HYDRAULIC PROPERTIES.

S.	.00039
F.D.	3.
B.W.	4'
A.	18.
W.P.	13.94 11.2
H.R.	1.29 1.61
V.	1.18 1.27
Cap.	21.5 23.


n=.0030 C=123 ±
Side slope 2:3

HYDRAULIC PROPERTIES.

S.	.00754
F.D.	1.4
B.W.	4.
A.	6.90
W.P.	7.34
H.R.	0.94
V.	1.17
Cap.	8.10

n=.0238 C=44.1
Side slope 2:3.

PLAN
LINES D2 b & D2 b1

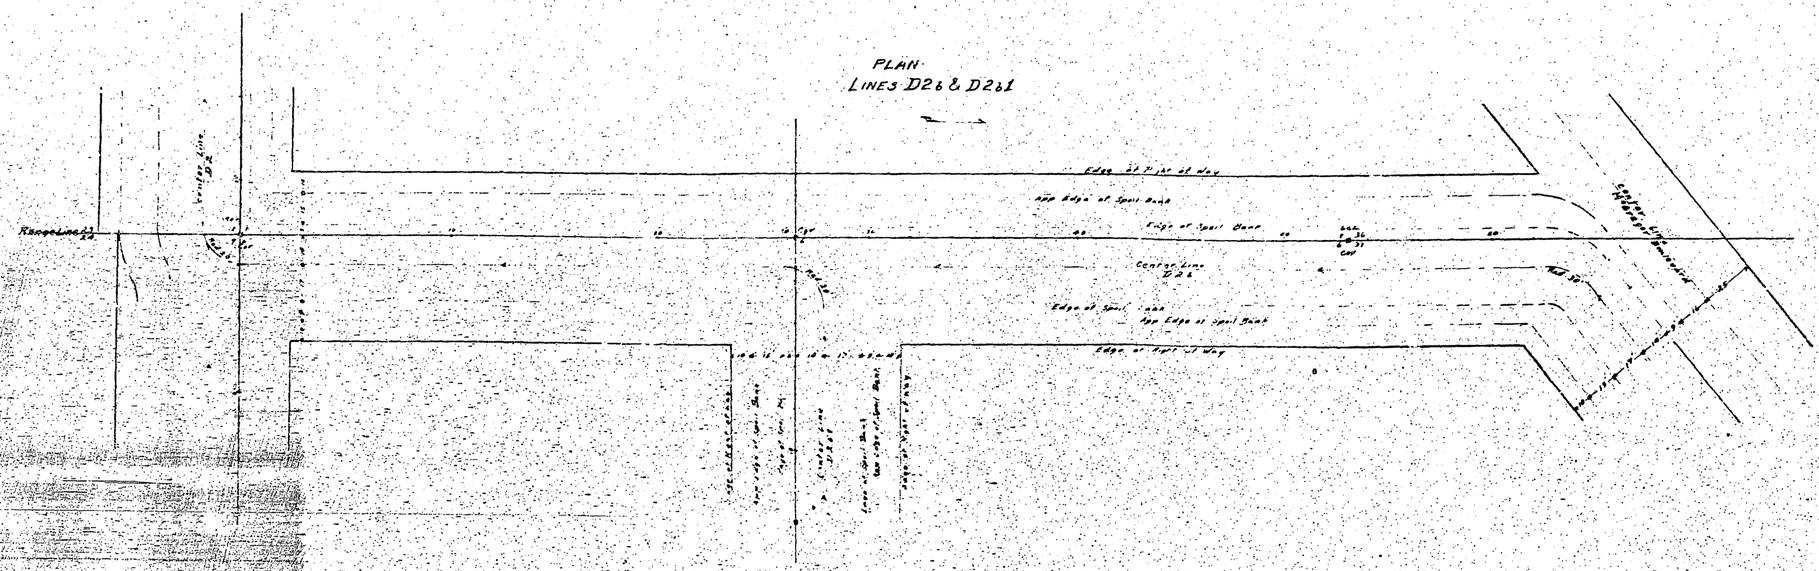

IONA DRAINAGE DISTRICT.


Lee County, Florida.

A. L. White,
Chief Engineer


Hor. Scale 1" 400
Vert Scale 1" 4'

Folio B
Sheet 18

PROFILE
LINE D 2a.

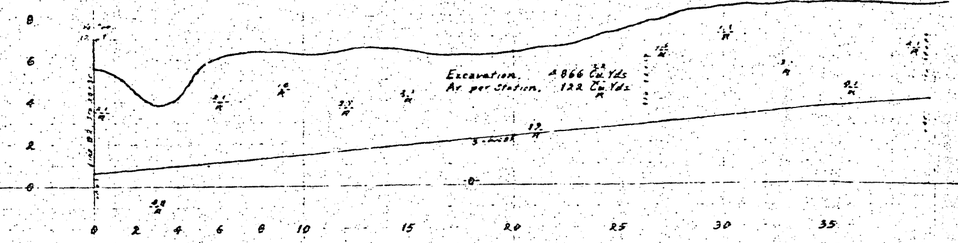

PROFILE
LINE D 2c.

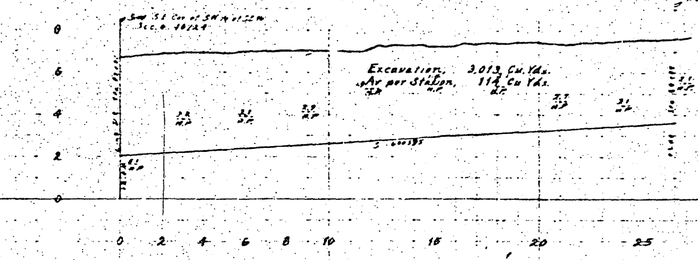

HYDRAULIC PROPERTIES.

S	.00085
F.D	1.5
B.W	4.
A	7.50
W.P	7.60
H.R	0.99
V	1.30
Cap	9.75


n = 0.030 c = 45.
Side slope 2:3.

HYDRAULIC PROPERTIES.

S	.000595
F.D	3.
B.W.	4.
A	19.
W.P	~~14.94~~ 11.2
H.R.	~~1.239~~ 1.61
V	~~1.647~~ 1.58
Cap.	~~25.09~~ 29.4

n = 0.030 c = 49.57
Side slope 2:3

PLAN
LINE D2a.

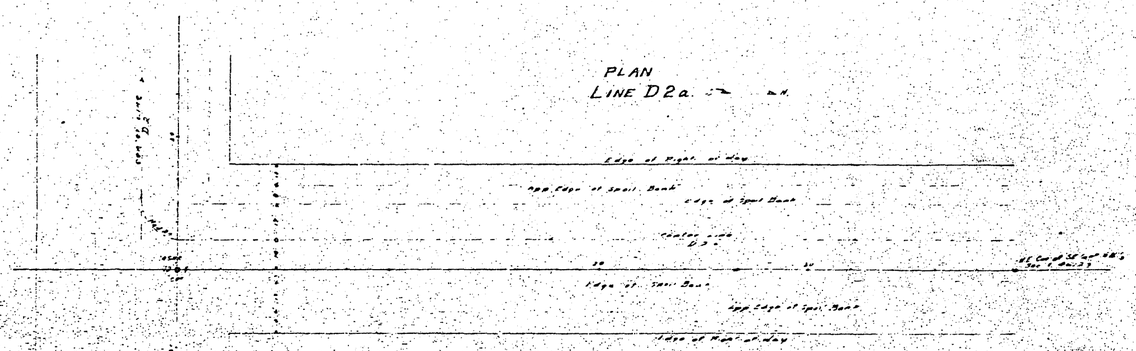

PLAN.
LINE D2c.

